CWW 18385 WATER WELL RECORD Form WWC-5 KSA 82a-1212 Merkle #2-8

1 LOCATION OF WATER WELL: County: Meade | Fraction: NW ¼ SE ¼ NW ¼ | Section Number: 8 | Township Number: T 35 S | Range Number: R 28 E/W

Distance and direction from nearest town or city street address of well if located within city? Go South of Meade Lake to Gas plant then ½mi South 4mi East 2mi South East into location.

2 WATER WELL OWNER: Sage Drilling
RR#, St. Address, Box # : 222 Sutton Place
City, State, ZIP Code : Wichita, Kansas 67202
Board of Agriculture, Division of Water Resources Application Number: T 81-290

3 LOCATE WELL'S LOCATION WITH AN "X" IN SECTION BOX:

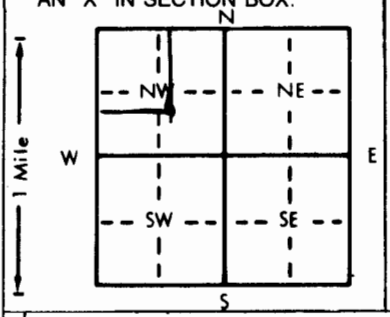

4 DEPTH OF COMPLETED WELL 280 ft. ELEVATION:
Depth(s) Groundwater Encountered 1. 163 ft. 2. ft. 3. ft.
WELL'S STATIC WATER LEVEL 117 ft. below land surface measured on mo/day/yr 5/14/81
Pump test data: Well water was ft. after hours pumping gpm
Est. Yield 60 gpm: Well water was ft. after hours pumping gpm
Bore Hole Diameter 9" in. to 280 ft., and in. to ft.
WELL WATER TO BE USED AS: 1 Domestic 2 Irrigation 3 Feedlot 4 Industrial 5 Public water supply 6 Oil field water supply 7 Lawn and garden only 8 Air conditioning 9 Dewatering 10 Observation well 11 Injection well 12 Other (Specify below)
Was a chemical/bacteriological sample submitted to Department? Yes No; If yes, mo/day/yr sample was submitted
Water Well Disinfected? Yes No

5 TYPE OF BLANK CASING USED: 1 Steel 2 PVC 3 RMP (SR) 4 ABS 5 Wrought iron 6 Asbestos-Cement 7 Fiberglass 8 Concrete tile 9 Other (specify below)
CASING JOINTS: Glued Clamped Welded Threaded
Blank casing diameter 5" in. to 200 ft., Dia in. to ft., Dia in. to ft.
Casing height above land surface 28 in., weight 2.78 lbs./ft. Wall thickness or gauge No. .256

TYPE OF SCREEN OR PERFORATION MATERIAL: 1 Steel 2 Brass 3 Stainless steel 4 Galvanized steel 5 Fiberglass 6 Concrete tile 7 PVC 8 RMP (SR) 9 ABS 10 Asbestos-cement 11 Other (specify) 12 None used (open hole)
SCREEN OR PERFORATION OPENINGS ARE: 1 Continuous slot 2 Louvered shutter 3 Mill slot 4 Key punched 5 Gauzed wrapped 6 Wire wrapped 7 Torch cut 8 Saw cut 9 Drilled holes 10 Other (specify) 11 None (open hole)
SCREEN-PERFORATED INTERVALS: From 200 ft. to 280 ft., From ft. to ft.
From ft. to ft., From ft. to ft.
GRAVEL PACK INTERVALS: From 100 ft. to 280 ft., From ft. to ft.
From ft. to ft., From ft. to ft.

6 GROUT MATERIAL: 1 Neat cement 2 Cement grout 3 Bentonite 4 Other
Grout Intervals: From 0 ft. to 10 ft., From ft. to ft., From ft. to ft.
What is the nearest source of possible contamination: 1 Septic tank 2 Sewer lines 3 Watertight sewer lines 4 Lateral lines 5 Cess pool 6 Seepage pit 7 Pit privy 8 Sewage lagoon 9 Feedyard 10 Livestock pens 11 Fuel storage 12 Fertilizer storage 13 Insecticide storage 14 Abandoned water well 15 Oil well/Gas well 16 Other (specify below)
Direction from well? Northeast How many feet? 100

FROM	TO	LITHOLOGIC LOG	FROM	TO	LITHOLOGIC LOG
0	2	surface			
2	15	clay			
15	32	sandy clay			
32	65	clay			
65	190	blue clay			
190	219	sandy clay			
219	250	fine sand			
250	255	sandy clay			
255	275	medium to large sand			
275	280	clay			

7 CONTRACTOR'S OR LANDOWNER'S CERTIFICATION: This water well was (1) constructed, (2) reconstructed, or (3) plugged under my jurisdiction and was completed on (mo/day/year) May 14, 1981 and this record is true to the best of my knowledge and belief. Kansas Water Well Contractor's License No. 118 This Water Well Record was completed on (mo/day/yr) May 28, 1981 under the business name of Carlile Water Well Service, Inc by (signature) Edward E. Means

INSTRUCTIONS: Use typewriter or ball point pen, *PLEASE PRESS FIRMLY* and *PRINT* clearly. Please fill in blanks, underline or circle the correct answers. Send top three copies to Kansas Department of Health and Environment, Division of Environment, Environmental Geology Section, Topeka, KS 66620. Send one to WATER WELL OWNER and retain one for your records.

OFFICE USE ONLY T 35 R 28 E/W SEC. 8 NW ¼ SE ¼ NW ¼