

USE TYPEWRITER OR BALL
POINT PEN-PRESS FIRMLY,
PRINT CLEARLY.

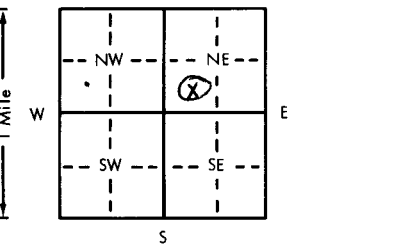
WATER WELL RECORD
KSA 82a-1201-1215

Kansas Department of Health and
Environment-Division of Environment
(Water well Contractors)
Topeka, Kansas 66620

CWW Inv # 13091

Barroogree 3-8

RECORD
1-1215

1. Location of well:		County Meade	Fraction 1/4 SW 1/4 NE 1/4	Section number 8	Township number T 35 S	Range number R 28 E/W
2. Distance and direction from nearest town or city: 3/4 S of Port of Entry, 2 1/2 South, 1/2 West to loc. 3/4 S			3. Owner of well: Triad Drilling Co. R.R. or street: 1100 Bitting Bldg. City, state, zip code: Wichita, Kansas 67202			
4. Locate with "X" in section below: 			6. Bore hole dia. 9 in. Completion date 1-21- Well depth 360 ft.			
5. Type and color of material			7. <input checked="" type="checkbox"/> Cable tool <input checked="" type="checkbox"/> Rotary <input type="checkbox"/> Driven <input type="checkbox"/> Dug <input type="checkbox"/> Hollow rod <input type="checkbox"/> Jetted <input type="checkbox"/> Bored <input type="checkbox"/> Reverse rotary			
			8. Use: <input type="checkbox"/> Domestic <input type="checkbox"/> Public supply <input type="checkbox"/> Industry <input type="checkbox"/> Irrigation <input type="checkbox"/> Air conditioning <input type="checkbox"/> Stock <input type="checkbox"/> Lawn <input checked="" type="checkbox"/> Oil field water <input type="checkbox"/> Other			
			9. Casing: Material <input type="checkbox"/> Height: Above or below Threaded <input type="checkbox"/> Welded <input type="checkbox"/> Surface 28 in. RMP <input type="checkbox"/> PVC <input checked="" type="checkbox"/> Weight 2.78 lbs./ft. Dia. 5 in. to 255 ft. depth Wall Thickness: 1/8 in. Dia. 5 in. to 360 ft. depth Gauge No. 285			
			10. Screen: Manufacturer's name sawed perf. Type PVC Dia. 5" Slot/gauze 100 Length 100 Set between 255 ft. and 355 ft. Gravel pack? yes Size range of material 1/8 to			
			11. Static water level: 120 ft. below land surface Date 1-21-77 12. Pumping level below land surfaces: ____ ft. after ____ hrs. pumping ____ g.p.m. ____ ft. after ____ hrs. pumping ____ g.p.m. Estimated maximum yield 60 g.p.m.			
13. Water sample submitted: Yes <input checked="" type="checkbox"/> No <input type="checkbox"/> Date ____			14. Well head completion: <input type="checkbox"/> Pitless adapter 28 inches above grade			
15. Well grouted? yes With: <input checked="" type="checkbox"/> Neat cement <input type="checkbox"/> Bentonite <input type="checkbox"/> Concrete Depth: From 0 ft. to 10 ft.			16. Nearest source of possible contamination: ft. 100 Direction NE Type oil well Well disinfected upon completion? <input checked="" type="checkbox"/> Yes <input type="checkbox"/> No			
17. Pump: <input checked="" type="checkbox"/> Not installed Manufacturer's name ____ Model number ____ HP ____ Volts ____ Length of drop pipe ____ ft. capacity ____ g.p.m. Type: <input type="checkbox"/> Submersible <input type="checkbox"/> Turbine <input type="checkbox"/> Jet <input type="checkbox"/> Reciprocating <input type="checkbox"/> Centrifugal <input type="checkbox"/> Other			18. Elevation: ____ Topography: ____ Hill ____ Slope <input checked="" type="checkbox"/> Upland ____ Valley			
19. Remarks: 700 mch relief			20. Water well contractor's certification: This well was drilled under my jurisdiction and this report is true to the best of my knowledge and belief. Carlile Water Well 118 Business name License No. ____ Address Box 275, Liberal, Ks. Signed Edward E. Means Date 1-28 Authorized representative			

Forward the white, blue and pink copies to the Department of Health and Environment

Form WWC-5

MI-1023