

USE TYPEWRITER OR BALL
POINT PEN-PRESS FIRMLY,
PRINT CLEARLY.

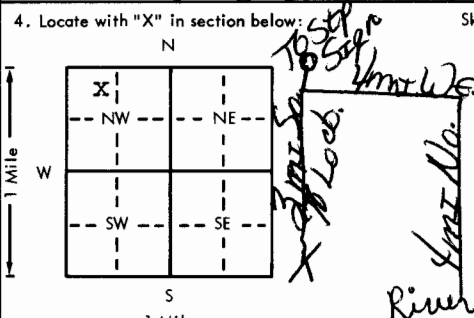
WATER WELL RECORD
KSA 82a-1201-1215

Kansas Department of Health and
Environment-Division of Environment
(Water well Contractors)
Topeka, Kansas 66620

CWV Inv. #13711

Barragsee 2-17

Handwritten notes:
1/4 NW 1/4 NW 1/4

1. Location of well:		County Meade	Fraction 900' FNL-700' FWL 1/4 NW 1/4 NW 1/4	Section number 17	Township number T 35s	Range number S R 28w E/W
2. Distance and direction from nearest town or city: Hwy 23 North of Forgan to Meade - 4 mi. No. of River - 4 mi. Street address of well location if in city: We. to stop sign-3 mi. So. (1 mi. county rd.)			3. Owner of well: Service Drilling Company R.R. or street: Box 910 City, state, zip code: Borger, Tx 79007			
4. Locate with "X" in section below: 			Sketch map: 2 mi. Lease rd.			
5. Type and color of material			From	To	6. Bore hole dia. 9 in. Completion date 8-6-77 Well depth 180 ft.	
Surface			0	2	7. <input checked="" type="checkbox"/> Cable tool <input checked="" type="checkbox"/> Rotary <input type="checkbox"/> Driven <input type="checkbox"/> Dug <input type="checkbox"/> Hollow rod <input type="checkbox"/> Jetted <input type="checkbox"/> Bored <input type="checkbox"/> Reverse rotary	
Clay, Brown & blue			2	80	8. Use: <input type="checkbox"/> Domestic <input type="checkbox"/> Public supply <input checked="" type="checkbox"/> Industry <input type="checkbox"/> Irrigation <input type="checkbox"/> Air conditioning <input type="checkbox"/> Stock <input type="checkbox"/> Lawn <input checked="" type="checkbox"/> Oil field water <input type="checkbox"/> Other	
Medium to large sand & sandy clay, brown & blue 80-20			80	170	9. Casing: Material <input type="checkbox"/> Height: Above or below Threaded <input type="checkbox"/> Welded <input type="checkbox"/> Surface 28 in. RMP <input type="checkbox"/> PVC <input checked="" type="checkbox"/> Weight 2.78 lbs./ft. Dia. 5 in. to 110 ft. depth Wall Thickness: inches or Dia. 5 in. to 180 ft. depth gauge No. .265	
Sandy clay, Brown			170	180	10. Screen: Manufacturer's name Sawed perf. Type PVC Dia. 5" Slot/gauze 60' Length 60' Set between 110 ft. and 170 ft. Gravel pack? yes Size range of material 1/8-3/16	
					11. Static water level: 40 ft. below land surface Date 8/6/77	
					12. Pumping level below land surfaces: ____ ft. after ____ hrs. pumping ____ g.p.m. ____ ft. after ____ hrs. pumping ____ g.p.m. Estimated maximum yield 60 g.p.m.	
					13. Water sample submitted: ____ mo./day/yr. Yes <input checked="" type="checkbox"/> No <input type="checkbox"/> Date ____	
					14. Well head completion: ____ Pitless adapter 28 inches above grade	
					15. Well grouted? yes With: <input checked="" type="checkbox"/> Neat cement <input type="checkbox"/> Bentonite <input type="checkbox"/> Concrete Depth: From 0 ft. to 10 ft.	
					16. Nearest source of possible contamination: ft. 100 Direction NE Type oilwell Well disinfected upon completion? <input checked="" type="checkbox"/> Yes <input type="checkbox"/> No	
					17. Pump: <input checked="" type="checkbox"/> Not installed Manufacturer's name ____ Model number ____ HP ____ Volts ____ Length of drop pipe ____ ft. capacity ____ g.p.m. Type: <input type="checkbox"/> Submersible <input type="checkbox"/> Turbine <input type="checkbox"/> Jet <input type="checkbox"/> Reciprocating <input type="checkbox"/> Centrifugal <input type="checkbox"/> Other	
18. Elevation: 2280 ft. Topography: <input type="checkbox"/> Hill <input type="checkbox"/> Slope <input checked="" type="checkbox"/> Upland <input type="checkbox"/> Valley			19. Remarks: 2280			
			20. Water well contractor's certification: This well was drilled under my jurisdiction and this report is true to the best of my knowledge and belief. Carlile Water Well Service 118 Business name License No. ____ Address Box 275, Liberal, KS Signed Edward E. Means Date 8/23/77 Authorized representative			

Forward the white, blue and pink copies to the Department of Health and Environment

Form WWC-5