

USE TYPEWRITER OR BALL POINT PEN-PRESS FIRMLY, PRINT CLEARLY.

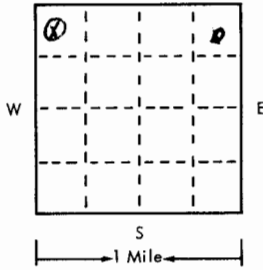
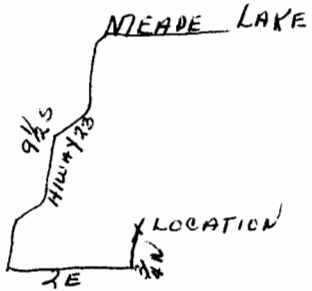
T R EW sec 1/4 1/4 1/4 No.

WATER WELL RECORD
KSA 82a-1201-1215

Kansas State Dept. Of Health
(Water Well Contractors)
Forbes-Bldg. 740
Topeka, Kansas 66620

Adams 1-3

CWW Inv. # 11723

1 Location of well:	County Meade	Township name	Fraction NW NW	Section number 3	Town number 35S	Range number 29W			
Distance and direction from nearest town or city: 11 miles south, 2 east, 3/4 north of Meade Lake Street address of well location if in city:				3 Owner of well: Service Drilling Company Ex Rig #4 Address: Box 910 Borger, Texas 79007					
Locate with "X" in section below: 				Sketch map: 			4 Well depth: 240 ft. Date of completion 10-6-75 Well diameter 9 in.		
2 Type and color of material				From		To		5 <input type="checkbox"/> Cable tool <input checked="" type="checkbox"/> Rotary <input type="checkbox"/> Driven <input type="checkbox"/> Dug <input type="checkbox"/> Hollow rod <input type="checkbox"/> Jetted <input type="checkbox"/> Bored <input type="checkbox"/> Reverse rotary	
								6 Use: <input type="checkbox"/> Domestic <input type="checkbox"/> Public supply <input checked="" type="checkbox"/> Industry <input type="checkbox"/> Irrigation <input type="checkbox"/> Air conditioning <input type="checkbox"/> Commercial <input type="checkbox"/> Test well <input type="checkbox"/> Oil Rig	
Surface				0		2		7 Casing: Material PVC Height: above/below Threaded <input type="checkbox"/> Welded <input type="checkbox"/> Surface 28 in. Digm. Weight 2.78 lbs./ft. 5 in. to 120 depth Drive shoe? <input type="checkbox"/> Yes <input checked="" type="checkbox"/> No 5 in. to 240 depth	
Sandy clay				2		118		8 Screen: Manufacturer sawed perf. Type PVC Dia. 5 Slot/gauze 7.030 Length 110 Set between 120 ft. and 230 ft. Fittings: 1/8 to 3/16 Gravel pack <input checked="" type="checkbox"/> Yes <input type="checkbox"/> No Size range of material	
Medium to large sand				118		190		9 Static water level: 60 ft. below land surface Date 10-6-75	
Medium to large sand and sandy clay 80-20				190		240		10 Pumping level below land surfaces: ____ ft. after ____ hrs. pumping ____ g.p.m. ____ ft. after ____ hrs. pumping ____ g.p.m. Estimated maximum yield 50 g.p.m.	
								11 Water sample submitted: <input type="checkbox"/> Yes <input checked="" type="checkbox"/> No Date	
								12 Well head completion: <input type="checkbox"/> Pitless adapter 28 inches above grade	
								13 Well grouted? <input checked="" type="checkbox"/> Yes <input type="checkbox"/> No <input checked="" type="checkbox"/> Neat cement <input type="checkbox"/> Bentonite <input type="checkbox"/> Depth: From 0 ft. to 200 ft.	
								14 Nearest source of possible contamination: ft. 100 Direction NE Type oilwell Well disinfected upon completion? <input checked="" type="checkbox"/> Yes <input type="checkbox"/> No	
								15 Pump: <input checked="" type="checkbox"/> Not installed Manufacturer's name _____ Model number _____ HP _____ Volts _____ Length of drop pipe _____ ft. capacity _____ g.m.p. Type: <input type="checkbox"/> Submersible <input type="checkbox"/> Turbine <input type="checkbox"/> Jet <input type="checkbox"/> Reciprocating <input type="checkbox"/> Centrifugal <input type="checkbox"/> Other	
16 Remarks: elevation								17 Water well contractor's certification: This well was drilled under my jurisdiction and this report is true to the best of my knowledge and belief. Carlile Water Well 118 Business name License No. Address Box 275, Liberal, Ks. Signed Edmund E. Means Date 10-21-75 Authorized representative	

35 29W 3 NW 1/4