

1 LOCATION OF WATER WELL:	Fraction	Section Number	Township Number	Range Number
County: Sumner	SE 1/4 SE 1/4 NW 1/4	2	T 35 S	R 3 EW


Distance and direction from nearest town or city street address of well if located within city?
21 North Main, Caldwell, Kansas 67022 KMW11

2	WATER WELL OWNER:	Marvin Kloefkorn	
	RR#, St. Address, Box # :	21 North Main	Board of Agriculture, Division of Water Resources
	City, State, ZIP Code :	Caldwell, Ks. 67022	Application Number:

3 LOCATE WELL'S LOCATION WITH AN "X" IN SECTION BOX:

4. DEPTH OF COMPLETED WELL..... 37 ft. ELEVATION:

Depth(s) Groundwater Encountered 1 34 # 2 # 3 #

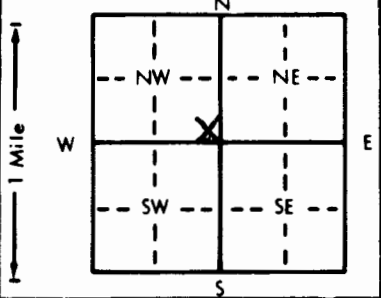

Depth(s) Groundwater Encountered 1. ft. 2. ft. 3. ft.

WELL'S STATIC WATER LEVEL 32.43 ft. below land surface measured on mo/day/yr 10-26-92

Pump test data: Well water was ft. after hours pumping gpm

Est. Yield gpm: Well water was ft. after hours pumping gpm

Bore Hole Diameter 7 5/8 . . . in. to 37 ft., and in. to ft.

WELL WATER TO BE USED AS:

5 Public water supply	8 Air conditioning	11 Injection well		
1 Domestic	3 Feedlot	6 Oil field water supply	9 Dewatering	12 Other (Specify below)
2 Irrigation	4 Industrial	7 Lawn and garden only	10 Monitoring well	

Was a chemical/bacteriological sample submitted to Department? Yes No ☒; If yes, mo/day/yr sample was submitted

Water Well Disinfected? Yes No ☒

5	TYPE OF BLANK CASING USED:		5 Wrought iron	8 Concrete tile	CASING JOINTS: Glued Clamped	
	1 Steel	3 RMP (SR)	6 Asbestos-Cement	9 Other (specify below)	Welded	
	2 PVC	4 ABS	7 Fiberglass		Threaded ☒	
Blank casing diameter		2	in. to	22	ft. Dia	in. to
Casing height above land surface		27	in., weight		lbs./ft. Wall thickness or gauge No.	Sch. 40

TYPE OF SCREEN OR PERFORATION MATERIAL:

1 Steel	3 Stainless steel	5 Fiberglass	7 PVC	10 Asbestos-cement
2 Brass	4 Galvanized steel	6 Concrete tile	8 RMP (SR)	11 Other (specify)
			9 ABS	12 None used (open hole)

SCREEN OR PERFORATION OPENINGS ARE:

1 Continuous slot	3 Mill slot	5 Gauzed wrapped	8 Saw cut	11 None (open hole)
2 Louvered shutter	4 Key punched	6 Wire wrapped	9 Drilled holes	
		7 Torch cut	10 Other (specify)	

SCREEN PERFORATED INTERVALS: From 22 ft to 37 ft From ft to ft

SCREEN-PERFORATED INTERVALS:		From ft. to ft.,		From ft. to ft.	
GRAVEL PACK INTERVALS:		From 20 ft. to 37 ft.,	From ft. to ft.,	From ft. to ft.	From ft. to ft.
		From ft. to ft.,	From ft. to ft.	From ft. to ft.	From ft. to ft.

6 GROUT MATERIAL: 1 Neat cement (2) Cement grout (3) Bentonite 4 Other
Grout Intervals: From 0 ft. to 1 ft. From 1 ft. to 20 ft. From ft. to ft.
What is the nearest source of possible contamination:
1 Septic tank 4 Lateral lines 7 Pit privy 10 Livestock pens 14 Abandoned water well
2 Sewer lines 5 Cess pool 8 Sewage lagoon (11) Fuel storage 15 Oil well/Gas well
3 Watertight sewer lines 6 Seepage pit 9 Feedyard 12 Fertilizer storage 16 Other (specify below)
13 Insecticide storage
Direction from well? Southeast How many feet? 1270

[illegible]

7 CONTRACTOR'S OR LANDOWNER'S CERTIFICATION: This water well was (1) constructed, (2) reconstructed, or (3) plugged under my jurisdiction and was completed on (mo/day/year) 09-18-92 and this record is true to the best of my knowledge and belief. Kansas Water Well Contractor's License No. 527 This Water Well Record was completed on (mo/day/yr) 10-12-92 under the business name of GeoCore Services, Inc. by (signature) Doug Han