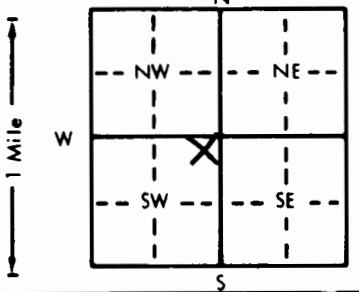


1 LOCATION OF WATER WELL: County: <u>Sumner</u>		Fraction <u>NE</u> $\frac{1}{4}$ <u>NE</u> $\frac{1}{4}$ <u>SW</u> $\frac{1}{4}$	Section Number <u>2</u>	Township Number <u>T</u> <u>35</u> <u>S</u>	Range Number <u>R</u> <u>3</u> <u>EW</u>
Distance and direction from nearest town or city street address of well if located within city? <u>21 North Main, Caldwell, Kansas 67022 KMW22</u>					
2 WATER WELL OWNER: RR#, St. Address, Box # : City, State, ZIP Code		Marvin Kloefkorn 21 North Main Caldwell, Ks. 67022 Board of Agriculture, Division of Water Resources Application Number:			
3 LOCATE WELL'S LOCATION WITH AN "X" IN SECTION BOX: 		4 DEPTH OF COMPLETED WELL <u>29.5</u> ft. ELEVATION: Depth(s) Groundwater Encountered <u>1</u> <u>24</u> ft. <u>2</u> <u>3</u> ft. WELL'S STATIC WATER LEVEL <u>24.14</u> ft. below land surface measured on <u>mo/day/yr</u> <u>10-26-92</u> Pump test data: Well water was <u> </u> ft. after <u> </u> hours pumping <u> </u> gpm Est. Yield <u> </u> gpm: Well water was <u> </u> ft. after <u> </u> hours pumping <u> </u> gpm Bore Hole Diameter <u>7 5/8</u> in. to <u>29.5</u> ft. and <u> </u> in. to <u> </u> ft. WELL WATER TO BE USED AS: 5 Public water supply 8 Air conditioning 11 Injection well 1 Domestic 3 Feedlot 6 Oil field water supply 9 Dewatering 12 Other (Specify below) 2 Irrigation 4 Industrial 7 Lawn and garden only <u>10</u> Monitoring well Was a chemical/bacteriological sample submitted to Department? Yes <u> </u> No <u>X</u> ; If yes, mo/day/yr sample was submitted Water Well Disinfected? Yes <u> </u> No <u>X</u>			
5 TYPE OF BLANK CASING USED: 1 Steel 3 RMP (SR) 5 Wrought iron 8 Concrete tile <u>2</u> PVC 4 ABS 6 Asbestos-Cement 9 Other (specify below) Blank casing diameter <u>2</u> in. to <u>14.5</u> ft. Dia <u> </u> in. to <u> </u> ft. Dia <u> </u> in. to <u> </u> ft. Casing height above land surface <u>0</u> in. weight <u> </u> lbs./ft. Wall thickness or gauge No. <u>Sch. 40</u> TYPE OF SCREEN OR PERFORATION MATERIAL: 1 Steel 3 Stainless steel 5 Fiberglass 8 RMP (SR) 10 Asbestos-cement 2 Brass 4 Galvanized steel 6 Concrete tile 9 ABS 11 Other (specify) <u> </u> 12 None used (open hole) SCREEN OR PERFORATION OPENINGS ARE: 1 Continuous slot <u>3</u> Mill slot 5 Gauzed wrapped 8 Saw cut 11 None (open hole) 2 Louvered shutter 4 Key punched 6 Wire wrapped 9 Drilled holes 7 Torch cut 10 Other (specify) <u> </u> SCREEN-PERFORATED INTERVALS: From <u>14.5</u> ft. to <u>29.5</u> ft. From <u> </u> ft. to <u> </u> ft. From <u> </u> ft. to <u> </u> ft. From <u> </u> ft. to <u> </u> ft. GRAVEL PACK INTERVALS: From <u>12.5</u> ft. to <u>29.5</u> ft. From <u> </u> ft. to <u> </u> ft. From <u> </u> ft. to <u> </u> ft. From <u> </u> ft. to <u> </u> ft.					
6 GROUT MATERIAL: 1 Neat cement <u>2</u> Cement grout <u>3</u> Bentonite 4 Other Grout Intervals: From <u>0</u> ft. to <u>1</u> ft. From <u>1</u> ft. to <u>12.5</u> ft. From <u> </u> ft. to <u> </u> ft. What is the nearest source of possible contamination: 1 Septic tank 4 Lateral lines 7 Pit privy <u>11</u> Fuel storage 14 Abandoned water well 2 Sewer lines 5 Cess pool 8 Sewage lagoon 12 Fertilizer storage 15 Oil well/Gas well 3 Watertight sewer lines 6 Seepage pit 9 Feedyard 13 Insecticide storage 16 Other (specify below) Direction from well? <u>Northeast</u> How many feet? <u>1020</u>					
FROM TO LITHOLOGIC LOG FROM TO PLUGGING INTERVALS					
0	7	Silty clay, reddish brown			
7	12	Sand, reddish brown, fine			Flush mount cover
12	18	Clay, reddish brown			Site ID # 00094913
18	22	Sandy clay, reddish brown			
22	25.2	Sand, reddish brown, fine to very coarse			
25.2	29.5	Weathered shale, red to grey, clay lenses			
29.5	-	Shale			
7 CONTRACTOR'S OR LANDOWNER'S CERTIFICATION: This water well was <u>1</u> constructed, (2) reconstructed, or (3) plugged under my jurisdiction and was completed on (mo/day/year) <u>09-25-92</u> and this record is true to the best of my knowledge and belief. Kansas Water Well Contractor's License No. <u>527</u> This Water Well Record was completed on (mo/day/yr) <u>10-12-92</u> under the business name of <u>GeoCore Services, Inc.</u> by (signature) <u>Doug Ray</u>					