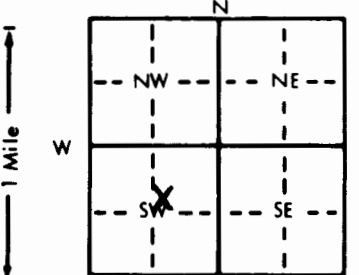


1 LOCATION OF WATER WELL:		Fraction SW 1/4 NE 1/4 SW 1/4		Section Number 2	Township Number T 35 S	Range Number R 3 EW
County: <u>Sumner</u>						
Distance and direction from nearest town or city street address of well if located within city? <u>21 North Main, Caldwell, Kansas 67022 KMW24</u>						
2 WATER WELL OWNER: <u>Marvin Kloefkorn</u> RR#, St. Address, Box # : <u>21 North Main</u> City, State, ZIP Code : <u>Caldwell, Ks. 67022</u> Board of Agriculture, Division of Water Resources Application Number:						
3 LOCATE WELL'S LOCATION WITH AN "X" IN SECTION BOX:		4 DEPTH OF COMPLETED WELL <u>30</u> ft. ELEVATION: _____ ft. Depth(s) Groundwater Encountered 1. <u>20</u> ft. 2. _____ ft. 3. _____ ft. WELL'S STATIC WATER LEVEL <u>22.45</u> ft. below land surface measured on mo/day/yr <u>10-26-92</u> Pump test data: Well water was _____ ft. after _____ hours pumping _____ gpm Est. Yield _____ gpm: Well water was _____ ft. after _____ hours pumping _____ gpm Bore Hole Diameter <u>7 5/8</u> in. to <u>30</u> ft. and _____ in. to _____ ft. WELL WATER TO BE USED AS: 5 Public water supply 8 Air conditioning 11 Injection well 1 Domestic 3 Feedlot 6 Oil field water supply 9 Dewatering 12 Other (Specify below) 2 Irrigation 4 Industrial 7 Lawn and garden only 10 Monitoring well Was a chemical/bacteriological sample submitted to Department? Yes _____ No <u>X</u> ; If yes, mo/day/yr sample was submitted _____ Water Well Disinfected? Yes _____ No <u>X</u>				
						
5 TYPE OF BLANK CASING USED: 1 Steel 3 RMP (SR) 5 Wrought iron 8 Concrete tile CASING JOINTS: Glued _____ Clamped _____ <u>2</u> PVC 4 ABS 6 Asbestos-Cement 9 Other (specify below) Welded _____ 7 Fiberglass Threaded <u>X</u> Blank casing diameter _____ in. to <u>15</u> ft. Dia _____ in. to _____ ft. Dia _____ in. to _____ ft. Casing height above land surface <u>24</u> in. weight _____ lbs./ft. Wall thickness or gauge No. <u>Sch. 40</u> TYPE OF SCREEN OR PERFORATION MATERIAL: <u>7</u> PVC 10 Asbestos-cement 1 Steel 3 Stainless steel 5 Fiberglass 8 RMP (SR) 11 Other (specify) _____ 2 Brass 4 Galvanized steel 6 Concrete tile 9 ABS 12 None used (open hole) SCREEN OR PERFORATION OPENINGS ARE: 5 Gauzed wrapped 8 Saw cut 11 None (open hole) 1 Continuous slot <u>3</u> Mill slot 6 Wire wrapped 9 Drilled holes 2 Louvered shutter 4 Key punched 7 Torch cut 10 Other (specify) _____ SCREEN-PERFORATED INTERVALS: From <u>15</u> ft. to <u>30</u> ft. From _____ ft. to _____ ft. GRAVEL PACK INTERVALS: From <u>13</u> ft. to <u>30</u> ft. From _____ ft. to _____ ft.						
6 GROUT MATERIAL: 1 Neat cement <u>2</u> Cement grout <u>3</u> Bentonite 4 Other _____ Grout Intervals: From <u>0</u> ft. to <u>1</u> ft. From <u>1</u> ft. to <u>13</u> ft. From _____ ft. to _____ ft. What is the nearest source of possible contamination: 1 Septic tank 4 Lateral lines 7 Pit privy <u>11</u> Fuel storage 14 Abandoned water well 2 Sewer lines 5 Cess pool 8 Sewage lagoon 12 Fertilizer storage 15 Oil well/Gas well 3 Watertight sewer lines 6 Seepage pit 9 Feedyard 13 Insecticide storage 16 Other (specify below) _____ Direction from well? <u>Northeast</u> How many feet? <u>2210</u>						
FROM		TO		LITHOLOGIC LOG		FROM TO PLUGGING INTERVALS
0		5		Silty clay, reddish brown		
5		25		Sandy clay, reddish brown		
25		30		Weathered shale, reddish brown, clay lenses		Above ground cover cover Site ID # 00094975
7 CONTRACTOR'S OR LANDOWNER'S CERTIFICATION: This water well was <u>(1)</u> constructed, <u>(2)</u> reconstructed, or <u>(3)</u> plugged under my jurisdiction and was completed on (mo/day/year) <u>09-25-92</u> and this record is true to the best of my knowledge and belief. Kansas Water Well Contractor's License No. <u>527</u> This Water Well Record was completed on (mo/day/yr) <u>10-12-92</u> under the business name of <u>GeoCore Services, Inc.</u> by (signature) <u>Doug Roy</u>						
INSTRUCTIONS: Use typewriter or ball point pen. PLEASE PRESS FIRMLY and PRINT clearly. Please fill in blanks, underline or circle the correct answers. Send up three copies to Kansas Department of Health and Environment, Bureau of Water, Topeka, Kansas 66620-0001. Telephone: 913-296-5545. Send one to WATER WELL OWNER and retain one for your records.						