

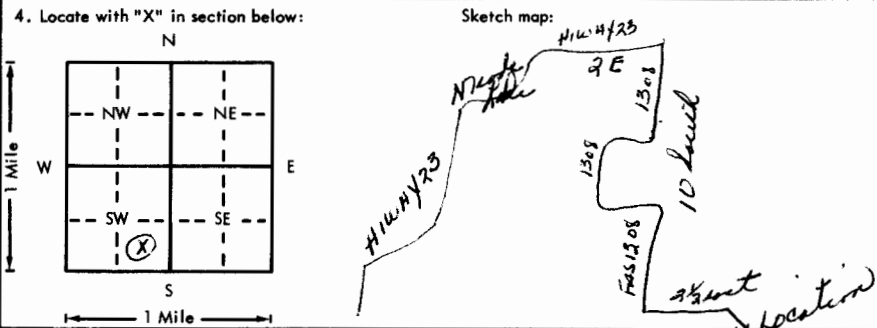
USE TYPEWRITER OR BALL
POINT PEN-PRESS FIRMLY,
PRINT CLEARLY.

WATER WELL RECORD
KSA 82a-1201-1215

Kansas Department of Health and
Environment-Division of Environment
(Water well Contractors)
Topeka, Kansas 66620

Fox #2

CWW Inv. # 12124

1. Location of well:		County Meade	Fraction 1/4 C SE 1/4 SW 1/4	Section number 3	Township number T 35S	Range number S R 30 E/W
2. Distance and direction from nearest town or city: Meade Lake, 10 south, 2 east and southeast to location.			3. Owner of well: Service Drilling Company R.R. or street: Box 910 City, state, zip code: Meade/ Borger, Texas 79007			
4. Locate with "X" in section below: 			6. Bore hole dia. 9 in. Completion date 3-11-76 Well depth 240 ft.			
5. Type and color of material			7. <input type="checkbox"/> Cable tool <input checked="" type="checkbox"/> Rotary <input type="checkbox"/> Driven <input type="checkbox"/> Dug <input type="checkbox"/> Hollow rod <input type="checkbox"/> Jetted <input type="checkbox"/> Bored <input type="checkbox"/> Reverse rotary			
Surface			8. Use: <input type="checkbox"/> Domestic <input type="checkbox"/> Public supply <input type="checkbox"/> Industry <input type="checkbox"/> Irrigation <input type="checkbox"/> Air conditioning <input type="checkbox"/> Stock <input type="checkbox"/> Lawn <input checked="" type="checkbox"/> Oil field water <input type="checkbox"/> Other			
Clay			9. Casing: Material <input type="checkbox"/> Height: Above or below Threaded <input type="checkbox"/> Welded <input type="checkbox"/> Surface 28 in. RMP <input type="checkbox"/> PVC <input checked="" type="checkbox"/> Weight 2.78 lbs./ft. Dia. 5 in. to 135 ft. depth; Wall Thickness: inches or Dia. 5 in. to 240 ft. depth; gage No. .265			
Sandy clay			10. Screen: Manufacturer's name sawed perf. Type PVC Dia. 5 in. Slot/gauze .030 Length 80 Set between 135 ft. and 215 ft. ft. and 215 ft. Gravel pack? yes Size range of material 1/8 to 3/16			
Clay			11. Static water level: 70 ft. below land surface Date 3-11-76			
Clay and fine sand 40-60			12. Pumping level below land surfaces: ft. after 0 hrs. pumping 60 g.p.m. ft. after 0 hrs. pumping 60 g.p.m. Estimated maximum yield 60 g.p.m.			
Clay, fine sand, & Med. to large sand			13. Water sample submitted: Yes <input checked="" type="checkbox"/> No <input type="checkbox"/> Date 3-11-76			
Clay and medium to large sand 60-40			14. Well head completion: 28 inches above grade			
Fine sand and medium to large sand			15. Well grouted? With <input checked="" type="checkbox"/> Neat cement <input type="checkbox"/> Bentonite <input type="checkbox"/> Concrete Depth: From 0 ft. to 10 ft.			
Redbed			16. Nearest source of possible contamination: oil well ft. 100 Direction NW Type oil well Well disinfected upon completion? <input checked="" type="checkbox"/> Yes <input type="checkbox"/> No			
18. Elevation:			20. Water well contractor's certification: This well was drilled under my jurisdiction and this report is true to the best of my knowledge and belief. Carlile Water Well 118 Business name Box 275, Liberal, Kansas License No. 118 Address Box 275, Liberal, Kansas Signed Edward E. Means Date 3-17 Authorized representative			
19. Remarks:						

Forward the white, blue and pink copies to the Department of Health and Environment

Form WWC-5