


1 LOCATION OF WATER WELL: Fraction $\frac{1}{4}$ C/NE $\frac{1}{4}$ NE $\frac{1}{4}$ Section Number 17 Township Number T 35 S Range Number R 30 E/W

Distance and direction from nearest town or city street address of well if located within city?
 From Forgan: 5W, 6N, 1E across c/g & follow rd N & E 2 mi & S into--

2 WATER WELL OWNER: Beredco, INC. #2-17 Adams
 RR#, St. Address, Box # : 401 E. Douglas, Suite 402 Board of Agriculture, Division of Water Resources
 City, State, ZIP Code : Wichita, KS 67202 Application Number: 920441

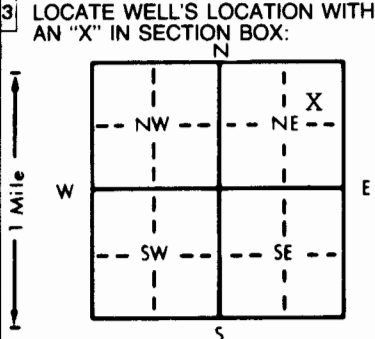

4 DEPTH OF COMPLETED WELL... 280 ft. ELEVATION: ...
 Depth(s) Groundwater Encountered 1. 60 ft. 2. ... ft. 3. ... ft.
 WELL'S STATIC WATER LEVEL ... 60 ft. below land surface measured on mo/day/yr ... 10/28/92.
 Pump test data: Well water was ... 140 ft. after ... 1 hours pumping ... 120 gpm
 Est. Yield .120 gpm: Well water was ... ft. after ... hours pumping ... gpm
 Bore Hole Diameter ... 9 1/2 in. to ... 280 ft., and ... in. to ... ft.
 WELL WATER TO BE USED AS: 5 Public water supply 8 Air conditioning 11 Injection well
 1 Domestic 3 Feedlot 6 Oil field water supply 9 Dewatering 12 Other (Specify below)
 2 Irrigation 4 Industrial 7 Lawn and garden only 10 Monitoring well
 Was a chemical/bacteriological sample submitted to Department? Yes.....No...X...; If yes, mo/day/yr sample was submitted
 Water Well Disinfected? Yes X No

5 TYPE OF BLANK CASING USED: 5 Wrought iron 8 Concrete tile CASING JOINTS: Glued X Clamped
 1 Steel 3 RMP (SR) 6 Asbestos-Cement 9 Other (specify below) Welded
 2 PVC 4 ABS 7 Fiberglass Threaded
 Blank casing diameter ... 5 in. to ... 280 ft., Dia ... in. to ... ft., Dia ... in. to ... ft.
 Casing height above land surface ... 24 in., weight ... 2.902 lbs./ft. Wall thickness or gauge No. ... 280 SDR21
 TYPE OF SCREEN OR PERFORATION MATERIAL: 7 PVC 10 Asbestos-cement
 1 Steel 3 Stainless steel 5 Fiberglass 8 RMP (SR) 11 Other (specify)
 2 Brass 4 Galvanized steel 6 Concrete tile 9 ABS 12 None used (open hole)
 SCREEN OR PERFORATION OPENINGS ARE: 5 Gauzed wrapped 8 Saw cut 11 None (open hole)
 1 Continuous slot 3 Mill slot 6 Wire wrapped 9 Drilled holes
 2 Louvered shutter 4 Key punched 7 Torch cut 10 Other (specify)
 SCREEN-PERFORATED INTERVALS: From ... 220 ft. to ... 280 ft., From ... ft. to ... ft.
 From ... ft. to ... ft., From ... ft. to ... ft.
 GRAVEL PACK INTERVALS: From ... 100 ft. to ... 280 ft., From ... ft. to ... ft.
 From ... ft. to ... ft., From ... ft. to ... ft.

6 GROUT MATERIAL: 1 Neat cement 2 Cement grout 3 Bentonite 4 Other Hole Plug
 Grout intervals: From ... 1 ft. to ... 20 ft., From ... ft. to ... ft., From ... ft. to ... ft.
 What is the nearest source of possible contamination:
 1 Septic tank 4 Lateral lines 7 Pit privy 10 Livestock pens 14 Abandoned water well
 2 Sewer lines 5 Cess pool 8 Sewage lagoon 11 Fuel storage 15 Oil well/Gas well
 3 Watertight sewer lines 6 Seepage pit 9 Feedyard 12 Fertilizer storage 16 Other (specify below)
 13 Insecticide storage
 Direction from well? Northwest How many feet? 170

FROM	TO	LITHOLOGIC LOG	FROM	TO	PLUGGING INTERVALS
0	4	Surface Soil			
4	17	Sandy Clay			
17	34	Clay			
34	46	Sandy Clay			
46	56	Clay			
56	265	Sand & Gravel			
265	270	Sandy Clay			
270	278	Gravel			
278	280	Red Bed			

7 CONTRACTOR'S OR LANDOWNER'S CERTIFICATION: This water well was (1) constructed, (2) reconstructed, or (3) plugged under my jurisdiction and was completed on (mo/day/year) ... KWWCL-430 ... and this record is true to the best of my knowledge and belief. Kansas Water Well Contractor's License No. ... 10/28/92 ... This Water Well Record was completed on (mo/day/yr) ... 10/28/92 ... under the business name of Howard Drilling Co Box 806 Beaver, OK by (signature) *Alva Howard*

INSTRUCTIONS: Use typewriter or ball point pen. PLEASE PRESS FIRMLY and PRINT clearly. Please fill in blanks, underline or circle the correct answers. Send two copies to Kansas Department of Health and Environment, Bureau of Water, Topeka, Kansas 66620-0001. Telephone: 913-296-5545. Send one to WATER WELL OWNER and retain one for your records.