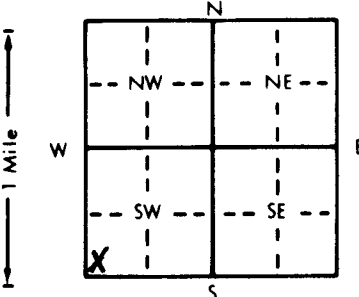


1 LOCATION OF WATER WELL: Fraction **SW 1/4 SW 1/4 SW 1/4** Section Number **4** Township Number **T 35 S** Range Number **R 31 EW**
 County: **Seward**

Distance and direction from nearest town or city street address of well if located within city?
Liberal; 12E on Blue Bell Rd. 1S., into

2 WATER WELL OWNER: **Seaboard Farms** **Franz W/W 2**
 RR#, St. Address, Box #: **P.O. Box 1207** Board of Agriculture, Division of Water Resources
 City, State, ZIP Code: **Guymon, Ok 73942** Application Number:

3 LOCATE WELL'S LOCATION WITH AN "X" IN SECTION BOX:

 4 DEPTH OF COMPLETED WELL: **480** ft. ELEVATION:
 Depth(s) Groundwater Encountered 1. **204** ft. 2. ft. 3. ft.
 WELL'S STATIC WATER LEVEL: **204** ft. below land surface measured on **6-12-97**
 Pump test data: Well water was **210** ft. after **1** hours pumping **125** gpm
 Est. Yield **125** gpm: Well water was ft. after hours pumping gpm
 Bore Hole Diameter: **11** in. to **480** ft., and in. to ft.
 WELL WATER TO BE USED AS:
 5 Public water supply 8 Air conditioning 11 Injection well
 1 Domestic 3 Feedlot 6 Dil field water supply 9 Dewatering 12 Other (Specify below)
 2 Irrigation 4 Industrial 7 Lawn and garden only 10 Monitoring well **Hog farm**
 Was a chemical/bacteriological sample submitted to Department? Yes.....No...**X**.....; If yes, mo/day/yr sample was submitted
 Water Well Disinfected? Yes **X** No

5 TYPE OF BLANK CASING USED:
 1 Steel 3 RMP (SR) 5 Wrought iron 8 Concrete tile CASING JOINTS: Glued **X** Clamped
 2 PVC 4 ABS 6 Asbestos-Cement 9 Other (specify below) Welded
 7 Fiberglass Threaded
 Blank casing diameter **6** in. to **480** ft., Dia in. to ft., Dia in. to ft.
 Casing height above land surface **24** in., weight **2.902** lbs./ft. Wall thickness or gauge No. **281. SDR 21**
 TYPE OF SCREEN OR PERFORATION MATERIAL:
 1 Steel 3 Stainless steel 5 Fiberglass 7 PVC 10 Asbestos-cement
 2 Brass 4 Galvanized steel 6 Concrete tile 8 RMP (SR) 11 Other (specify)
 9 ABS 12 None used (open hole)
 SCREEN OR PERFORATION OPENINGS ARE:
 1 Continuous slot 3 Mill slot 5 Gauzed wrapped 8 Saw cut 11 None (open hole)
 2 Louvered shutter 4 Key punched 6 Wire wrapped 9 Drilled holes
 7 Torch cut 10 Other (specify)
 SCREEN-PERFORATED INTERVALS: From **380** ft. to **480** ft., From ft. to ft.
 From ft. to ft., From ft. to ft.
 GRAVEL PACK INTERVALS: From **320** ft. to **480** ft., From ft. to ft.
 From ft. to ft., From ft. to ft.

6 GROUT MATERIAL: 1 Neat cement 2 Cement grout 3 Bentonite 4 Other **Hole Plug**
 Grout Intervals: From **0** ft. to **20** ft., From ft. to ft., From ft. to ft.
 What is the nearest source of possible contamination:
 1 Septic tank 4 Lateral lines 7 Pit privy 10 Livestock pens 14 Abandoned water well
 2 Sewer lines 5 Cess pool 8 Sewage lagoon 11 Fuel storage 15 Oil well/Gas well
 3 Watertight sewer lines 6 Seepage pit 9 Feedyard 12 Fertilizer storage 16 Other (specify below)
 13 Insecticide storage
 Direction from well? How many feet?

FROM	TO	LITHOLOGIC LOG	FROM	TO	PLUGGING INTERVALS
0	1	Surface			
1	14	Sandy Clay			
14	78	Caliche			
78	163	Sand			
163	198	Sand & Clay Streaks			
198	292	Sand			
292	310	Clay			
310	416	Sand			
416	431	Sand & Clay Streaks			
431	472	Sand			
472	480	Clay			

7 CONTRACTOR'S OR LANDOWNER'S CERTIFICATION: This water well was **(1)** constructed, (2) reconstructed, or (3) plugged under my jurisdiction and was completed on (mo/day/year) **6-12-97** and this record is true to the best of my knowledge and belief. Kansas Water Well Contractor's License No. **KWCL. = 430**. This Water Well Record was completed on (mo/day/yr) **6-12-97** under the business name of **Howard Drlg. Box 806 Beaver, Ok 73932** by (signature) *Howard Drlg.*

OFFICE USE ONLY T R EW SEC 1/4 1/4 1/4