


1 LOCATION OF WATER WELL: County: Seward Fraction: SE 1/4 SE 1/4 SW 1/4 Section Number: 10 Township Number: T 35 S Range Number: R 31 E 00

Distance and direction from nearest town or city street address of well if located within city?
13 1/2 East and 1 1/2 South from Liberal

2 WATER WELL OWNER: Walter Ross
 RR#, St. Address, Box #: Rt 2 Box 135 Board of Agriculture, Division of Water Resources
 City, State, ZIP Code: Liberal, KS, 67901 Application Number:

3 LOCATE WELL'S LOCATION WITH AN "X" IN SECTION BOX:

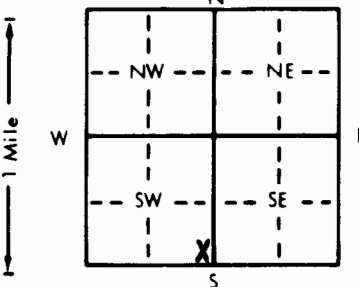

4 DEPTH OF COMPLETED WELL: 260 ft. ELEVATION:
 Depth(s) Groundwater Encountered 1. 220 ft. 2. 245 ft. 3. ft.
 WELL'S STATIC WATER LEVEL 179 ft. below land surface measured on mo/day/yr 9-14-88
 Pump test data: Well water was 240 ft. after 1 hours pumping 15 gpm
 Est. Yield 20 gpm; Well water was ft. after hours pumping gpm
 Bore Hole Diameter: 8 3/4 in. to 260 ft., and in. to ft.
 WELL WATER TO BE USED AS: 5 Public water supply 8 Air conditioning 11 Injection well
 Domestic 3 Feedlot 6 Oil field water supply 9 Dewatering 12 Other (Specify below)
 2 Irrigation 4 Industrial 7 Lawn and garden only 10 Monitoring well
 Was a chemical/bacteriological sample submitted to Department? Yes No ; If yes, mo/day/yr sample was submitted
 Water Well Disinfected? Yes No

5 TYPE OF BLANK CASING USED: 1 Steel 3 RMP (SR) 5 Wrought iron 8 Concrete tile CASING JOINTS: Glued Clamped
 PVC 4 ABS 7 Fiberglass Welded
 Blank casing diameter 5 in. to 200 ft., Dia in. to ft., Dia in. to ft.
 Casing height above land surface 24 in., weight 200 lbs. Wall thickness or gauge No.

TYPE OF SCREEN OR PERFORATION MATERIAL: PVC 10 Asbestos-cement
 1 Steel 3 Stainless steel 5 Fiberglass 8 RMP (SR) 11 Other (specify)
 2 Brass 4 Galvanized steel 6 Concrete tile 9 ABS 12 None used (open hole)
 SCREEN OR PERFORATION OPENINGS ARE: 5 Gauzed wrapped Saw cut 11 None (open hole)
 1 Continuous slot 3 Mill slot 6 Wire wrapped 9 Drilled holes
 2 Louvered shutter 4 Key punched 7 Torch cut 10 Other (specify)

SCREEN-PERFORATED INTERVALS: From 200 ft. to 260 ft., From ft. to ft.
 From used 80sch 260-240 ft., From ft. to ft.
 GRAVEL PACK INTERVALS: From 20 ft. to 260 ft., From ft. to ft.
 From ft. to ft., From ft. to ft.

6 GROUT MATERIAL: 1 Neat cement Cement grout 3 Bentonite 4 Other
 Grout Intervals: From top ft. to 20 ft., From ft. to ft., From ft. to ft.

What is the nearest source of possible contamination:
 1 Septic tank 4 Lateral lines 7 Pit privy 10 Livestock pens 14 Abandoned water well
 2 Sewer lines 5 Cess pool 8 Sewage lagoon 11 Fuel storage 15 Oil well/Gas well
 3 Watertight sewer lines 6 Seepage pit 9 Feedyard 12 Fertilizer storage 16 Other (specify below)
3 Direction from well? S 13 Insecticide storage overflow from tank
 How many feet? 50

FROM	TO	LITHOLOGIC LOG	FROM	TO	PLUGGING INTERVALS
0	5	sand			
5	15	brown clay			
15	90	white clay			
90	110	brown clay			
110	120	sand + gravel			
120	200	brown clay			
200	210	blue clay			
210	230	sand + gravel			
230	245	blue clay			
245	260	sand + gravel			

7 CONTRACTOR'S OR LANDOWNER'S CERTIFICATION: This water well was constructed, (2) reconstructed, or (3) plugged under my jurisdiction and was completed on (mo/day/year) 9-16-88 and this record is true to the best of my knowledge and belief. Kansas Water Well Contractor's License No. 101 This Water Well Record was completed on (mo/day/yr) 9-16-88 under the business name of Bartel Well Drilling by (signature) Reuben Bartel

OFFICE USE ONLY
T
R
EW
SEC.
1/4
1/4
1/4