


1 LOCATION OF WATER WELL: Fraction S2 1/4 NE 1/4 NE 1/4 Section Number 3 Township Number T 35S S Range Number R 31W E/W

Distance and direction from nearest town or city street address of well if located within city?

6 MILES SOUTHEAST HAYNE, KS

2 WATER WELL OWNER: TAYLOR R C COMPANIES #2 KANSAS CITY LIFE  
 RR#, St. Address, Box # : 501 W I-44 STE 590 Board of Agriculture, Division of Water Resources  
 City, State, ZIP Code : OKLAHOMA CITY, OK 73118 Application Number: 94 0414

3 LOCATE WELL'S LOCATION WITH AN "X" IN SECTION BOX:

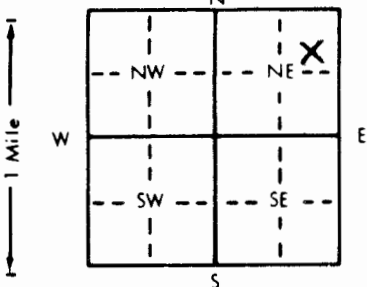

4 DEPTH OF COMPLETED WELL: 280 ft. ELEVATION:  
 Depth(s) Groundwater Encountered 1. 200 ft. 2. ft. 3. ft.  
 WELL'S STATIC WATER LEVEL: 200 ft. below land surface measured on mo/day/yr 10-10-94  
 Pump test data: Well water was 215 ft. after 1 hours pumping 40 gpm  
 Est. Yield 40 gpm: Well water was ft. after hours pumping gpm  
 Bore Hole Diameter 9 1/2 in. to 280 ft. and in. to ft.  
 WELL WATER TO BE USED AS:  
 5 Public water supply 8 Air conditioning 11 Injection well  
 1 Domestic 3 Feedlot 6 Oil field water supply 9 Dewatering 12 Other (Specify below)  
 2 Irrigation 4 Industrial 7 Lawn and garden only 10 Monitoring well  
 Was a chemical/bacteriological sample submitted to Department? Yes No X; If yes, mo/day/yr sample was submitted  
 Water Well Disinfected? Yes X No

5 TYPE OF BLANK CASING USED:  
 1 Steel 3 RMP (SR) 5 Wrought iron 8 Concrete tile CASING JOINTS: Glued X Clamped  
 2 PVC 4 ABS 6 Asbestos-Cement 9 Other (specify below) Welded  
 7 Fiberglass Threaded  
 Blank casing diameter 5 in. to 280 ft. Dia in. to ft. Dia in. to ft.  
 Casing height above land surface 24 in. weight 2.902 lbs./ft. Wall thickness or gauge No. 265 SDR 21

TYPE OF SCREEN OR PERFORATION MATERIAL:  
 1 Steel 3 Stainless steel 5 Fiberglass 7 PVC 10 Asbestos-cement  
 2 Brass 4 Galvanized steel 6 Concrete tile 8 RMP (SR) 11 Other (specify)  
 12 None used (open hole)

SCREEN OR PERFORATION OPENINGS ARE:  
 1 Continuous slot 3 Mill slot 5 Gauzed wrapped 8 Saw cut 11 None (open hole)  
 2 Louvered shutter 4 Key punched 6 Wire wrapped 9 Drilled holes  
 7 Torch cut 10 Other (specify)

SCREEN-PERFORATED INTERVALS: From 160 ft. to 180 ft. From 200 ft. to 240 ft.  
 From 260 ft. to 280 ft. From ft. to ft.  
 GRAVEL PACK INTERVALS: From 140 ft. to 280 ft. From ft. to ft.  
 From ft. to ft. From ft. to ft.

6 GROUT MATERIAL: 1 Neat cement 2 Cement grout 3 Bentonite 4 Other HOLE PLUG.  
 Grout Intervals: From 1 ft. to 20 ft. From ft. to ft. From ft. to ft.

What is the nearest source of possible contamination:  
 1 Septic tank 4 Lateral lines 7 Pit privy 10 Livestock pens 14 Abandoned water well  
 2 Sewer lines 5 Cess pool 8 Sewage lagoon 11 Fuel storage 15 Oil well/Gas well  
 3 Watertight sewer lines 6 Seepage pit 9 Feedyard 12 Fertilizer storage 16 Other (specify below)  
 13 Insecticide storage

Direction from well? How many feet?

FROM	TO	LITHOLOGIC LOG	FROM	TO	PLUGGING INTERVALS
0	2	TOP	232	252	BLUE CLAY
2	23	CALICHE	252	268	SAND
23	67	SANDY CLAY	268	280	BLUE CLAY W/SAND STREAKS
67	76	SAND			
76	84	SANDY CLAY			
84	145	SAND & SMALL GRAVEL			
145	151	CLAY			
151	172	SAND & SMALL GRAVEL			
172	177	YELLOW CLAY			
177	185	BLUE CLAY			
185	195	SANDY CLAY			
195	208	SAND			
208	225	SANDY CLAY			
225	231	SAND			
231	232	CLAY			

7 CONTRACTOR'S OR LANDOWNER'S CERTIFICATION: This water well was (1) constructed, (2) reconstructed, or (3) plugged under my jurisdiction and was completed on (mo/day/year) 10-10-94 and this record is true to the best of my knowledge and belief. Kansas Water Well Contractor's License No. KWWCL-430 This Water Well Record was completed on (mo/day/yr) 10-10-94 under the business name of HOWARD DRUG CO. BOX 806 BEAVER, OK 73932 by (signature) *Howard*

INSTRUCTIONS: Use typewriter or ball point pen. PLEASE PRESS FIRMLY and PRINT clearly. Please fill in blanks, underline or circle the correct answers. Send top three copies to Kansas Department of Health and Environment, Bureau of Water, Topeka, Kansas 66620-0001. Telephone: 913-296-5545. Send one to WATER WELL OWNER and retain one for your records.

#19469

OFFICE USE ONLY  
T  
R  
E/W  
SEC.