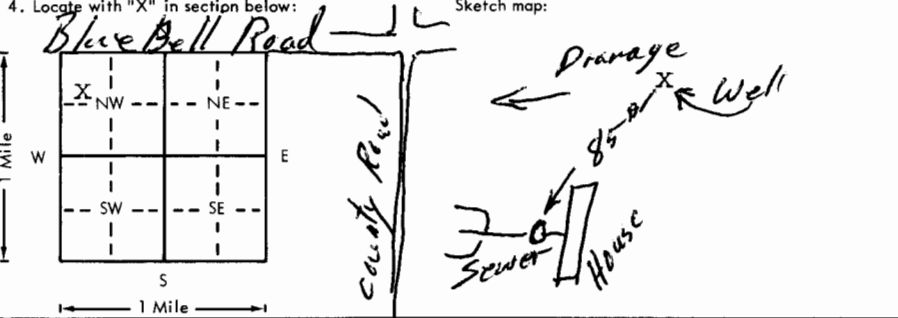


USE TYPEWRITER OR BALL POINT PEN-PRESS FIRMLY, PRINT CLEARLY.

WATER WELL RECORD
KSA 82a-1201-1215

Kansas Department of Health and Environment-Division of Environment
(Water well Contractors)
Topeka, Kansas 66620

| | | | | | | |
|---|--------------|-------------------------|--|---|---------------------------------------|--|
| 1. Location of well: | | County Seward | Fraction SW 1/4 NW 1/4 NW 1/4 | Section number 1 | Township number T 35 S R 32 | Range number 32 |
| 2. Distance and direction from nearest town or city: Street address of well location if in city: 7 mi/ E of Liberal | | | | 3. Owner of well: Jacke Waybright R.R. or street: RFD #2 City, state, zip code: Liberal Kansas 67901 | | |
| 4. Locate with "X" in section below:  | | | | 6. Bore hole dia. 9 in. Completion date 1-14-80 Well depth 270 ft. 1-14-1980 | | |
| 5. Type and color of material | | | | From | To | 7. <input type="checkbox"/> Cable tool <input checked="" type="checkbox"/> Rotary <input type="checkbox"/> Driven <input type="checkbox"/> Dug <input type="checkbox"/> Hollow rod <input type="checkbox"/> Jetted <input type="checkbox"/> Bored <input type="checkbox"/> Reverse rotary |
| Top Soil | | | | 0 | 2 | 8. Use: <input checked="" type="checkbox"/> Domestic <input checked="" type="checkbox"/> Public supply <input type="checkbox"/> Industry <input type="checkbox"/> Irrigation <input type="checkbox"/> Air conditioning <input type="checkbox"/> Stock <input type="checkbox"/> Lawn <input type="checkbox"/> Oil field water <input type="checkbox"/> Other |
| Fine Sand & Silt | | | | 2 | 11 | 9. Casing: Material pvc Height: Above 24 in. Threaded <input type="checkbox"/> Welded <input type="checkbox"/> Surface 24 in. RMP <input type="checkbox"/> PVC <input checked="" type="checkbox"/> Weight N/A lbs./ft. Dia. 6 in. to 6 ft. depth Wall Thickness: inches or Dia. 5 in. to 270 ft. depth gage No. 280 |
| Light Clay & fine sand | | | | 11 | 65 | 10. Screen: Manufacturer's name Lone Star 5" pvc casing hand slot Type pvc Dia. 5" Slot 1/8" Length 60" Set between 210 ft. and 270 ft. Gravel pack? yes Size range of material 1/8-1/4" |
| Corse sand | | | | 65 | 93 | 11. Static water level: mo./day/yr. 182 ft. below land surface Date 1-14-80 |
| Light Clay Slow Drilling | | | | 93 | 165 | 12. Pumping level below land surfaces: N/A ft. after hrs. pumping g.p.m. ft. after hrs. pumping g.p.m. Estimated maximum yield 60 g.p.m. |
| Limestone with sand | | | | 165 | 172 | 13. Water sample submitted: mo./day/yr. Yes <input type="checkbox"/> No <input checked="" type="checkbox"/> Date |
| White Chalk | | | | 172 | 189 | 14. Well head completion: <input checked="" type="checkbox"/> Pitless adapter 24 Inches above grade |
| Fine Sand & clay | | | | 189 | 238 | 15. Well grouted? yes With: <input type="checkbox"/> Neat cement <input type="checkbox"/> Bentonite <input checked="" type="checkbox"/> Concrete Depth: From 4 ft. to 14 ft. |
| Corse Sand & clay Stra | | | | 238 | 270 | 16. Nearest source of possible contamination: ft. 85" Direction sw Type sewer Well disinfected upon completion? <input checked="" type="checkbox"/> Yes <input type="checkbox"/> No |
| (Use a second sheet if needed) | | | | | | 17. Pump: Not installed Manufacturer's name Fairbanks Moris Model number 14s HP 1 1/2 Volts 230 Length of drop pipe 240 ft. capacity 16 g.p.m. Type: <input checked="" type="checkbox"/> Submersible <input type="checkbox"/> Turbine <input type="checkbox"/> Jet <input type="checkbox"/> Reciprocating <input type="checkbox"/> Centrifugal <input type="checkbox"/> Other |
| 18. Elevation: | 19. Remarks: | | 20. Water well contractor's certification: This well was drilled under my jurisdiction and this report is true to the best of my knowledge and belief. Combs Engineering 342 Business name 39 Turpin okla License No. 73950 Address 1-14- Signed Neal Combs Date 1-14- Authorized representative | | | |

35 32 1-14-80

Forward the white, blue and pink copies to the Department of Health and Environment

Form WWC-5