

1 LOCATION OF WATER WELL: County: <u>Seward</u>	Fraction <u>SE 1/4 SE 1/4 SE 1/4</u>	Section Number <u>5</u>	Township Number <u>T 35 S</u>	Range Number <u>R 32 E/W</u>
--	---	----------------------------	----------------------------------	---------------------------------


Distance and direction from nearest town or city street address of well if located within city?

4 mi. East of Liberal Ks. then 1/4 mi So.

2 WATER WELL OWNER: Liberal Feeders
 RR#, St. Address, Box #: Rt. 2 Box 150
 City, State, ZIP Code: Liberal, Ks. 67901

Board of Agriculture, Division of Water Resources
 Application Number: 41,117

3 LOCATE WELL'S LOCATION WITH AN "X" IN SECTION BOX:

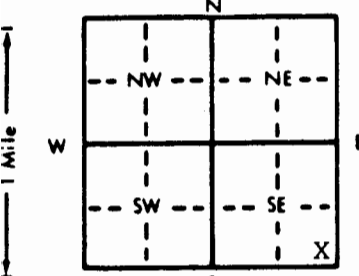

4 DEPTH OF COMPLETED WELL: 267 ft. ELEVATION: _____

Depth(s) Groundwater Encountered 1. _____ ft. 2. _____ ft. 3. _____ ft.

WELL'S STATIC WATER LEVEL Q ft. below land surface measured on mo/day/yr _____

Pump test data: Well water was None ft. after _____ hours pumping _____ gpr

Est. Yield _____ gpm: Well water was _____ ft. after _____ hours pumping _____ gpr

Bore Hole Diameter _____ in. to _____ ft., and _____ in. to _____ ft.

WELL WATER TO BE USED AS:

1 Domestic	3 <u>Feedlot</u>	6 Oil field water supply	9 Dewatering	12 Other (Specify below)
2 Irrigation	4 Industrial	7 Lawn and garden only	10 Observation well	

Was a chemical/bacteriological sample submitted to Department? Yes _____ No _____; If yes, mo/day/yr sample was submitted _____

Water Well Disinfected? Yes _____ No _____

5 TYPE OF BLANK CASING USED:

1 Steel	3 RMP (SR)	5 Wrought iron	8 Concrete tile	CASING JOINTS: Glued <u>X</u> Clamped _____
2 PVC	4 ABS	6 Asbestos-Cement	9 Other (specify below)	Welded _____
		7 Fiberglass		Threaded _____

Blank casing diameter 5 in. to _____ ft., Dia _____ in. to _____ ft., Dia _____ in. to _____ ft.

Casing height above land surface 0 in., weight _____ lbs./ft. Wall thickness or gauge No. _____

TYPE OF SCREEN OR PERFORATION MATERIAL:

1 Steel	3 Stainless steel	5 Fiberglass	8 RMP (SR)	11 Other (specify) _____
2 Brass	4 Galvanized steel	6 Concrete tile	9 ABS	12 None used (open hole)

SCREEN OR PERFORATION OPENINGS ARE:

1 Continuous slot	3 <u>Mill slot</u>	5 Gauzed wrapped	8 Saw cut	11 None (open hole)
2 Louvered shutter	4 Key punched	6 Wire wrapped	9 Drilled holes	
		7 Torch cut	10 Other (specify) _____	

SCREEN-PERFORATED INTERVALS: From 229 ft. to 267 ft., From _____ ft. to _____ ft.

GRAVEL PACK INTERVALS: From 20 ft. to 267 ft., From _____ ft. to _____ ft.

6 GROUT MATERIAL: 1 Neat cement 2 Cement grout 3 Bentonite 4 Other _____

Grout intervals: From TOP ft. to 20 ft., From _____ ft. to _____ ft., From _____ ft. to _____ ft.

What is the nearest source of possible contamination:

1 Septic tank	4 Lateral lines	7 Pit privy	10 Livestock pens	14 Abandoned water well
2 Sewer lines	5 Cess pool	8 Sewage lagoon	11 Fuel storage	15 Oil well/Gas well
3 Watertight sewer lines	6 Seepage pit	9 <u>Feedyard</u>	12 Fertilizer storage	16 Other (specify below)
			13 Insecticide storage	

Direction from well? _____ How many feet? 1200

FROM	TO	LITHOLOGIC LOG	FROM	TO	LITHOLOGIC LOG
0	88	Top & Clay			
88	262	Sand (fine) & clay			
262	267	Clay			

7 CONTRACTOR'S OR LANDOWNER'S CERTIFICATION: This water well was (1) constructed, (2) reconstructed, or (3) plugged under my jurisdiction and was completed on (mo/day/year) 3-16-95 and this record is true to the best of my knowledge and belief. Kansas Water Well Contractor's License No. 123 This Water Well Record was completed on (mo/day/yr) 3-27-95 under the business name of Ark Valley Pump & Supply by (signature) Dave Smith by cap

INSTRUCTIONS: Use typewriter or ball point pen. PLEASE PRESS FIRMLY and PRINT clearly. Please fill in blanks, underline or circle the correct answers. Send top three copies to Kansas Department of Health and Environment, Bureau of Water Protection, Topeka, Kansas 66620-7200, Telephone: 913-862-9360. Send one to WATER WELL OWNER and retain one for your records.