


1 LOCATION OF WATER WELL: Fraction **NW 1/4 NW 1/4 SW 1/4** Section Number **4** Township Number **T 35 S** Range Number **R 33** **EW**
 County: **Seward**

Distance and direction from nearest town or city street address of well if located within city?
130' East & 200' South of Pancake & Washington

2 WATER WELL OWNER: **Weaver General Store**
 RR#, St. Address, Box # : **420 South Washington** Board of Agriculture, Division of Water Resources
 City, State, ZIP Code : **Liberal, Kansas** Application Number:

3 LOCATE WELL'S LOCATION WITH AN "X" IN SECTION BOX:

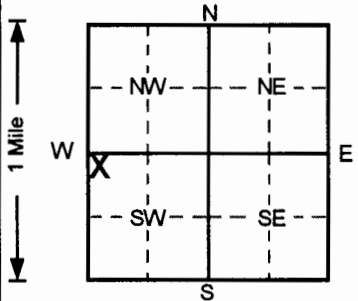

4 DEPTH OF COMPLETED WELL: **158** ft. ELEVATION: **2839.66**
 Depth(s) Groundwater Encountered 1. **148** ft. 2. _____ ft. 3. _____ ft.
 WELL'S STATIC WATER LEVEL: **147.93** ft. below land surface measured on mo/day/yr **10/11/95**
 Pump test data: Well water was **NA** ft. after _____ hours pumping _____ gpm
 Est. Yield **NA** gpm: Well water was _____ ft. after _____ hours pumping _____ gpm
 Bore Hole Diameter **8** in. to **160** ft., and _____ in. to _____ ft.
 WELL WATER TO BE USED AS:
 5 Public water supply 8 Air conditioning 11 Injection well
 1 Domestic 3 Feedlot 6 Oil field water supply 9 Dewatering 12 Other (Specify below)
 2 Irrigation 4 Industrial 7 Lawn and garden only **10** Monitoring well
 Was a chemical/bacteriological sample submitted to Department? Yes _____ No ; If yes, mo/day/yr sample was submitted
 Water Well Disinfected? Yes _____ No

5 TYPE OF BLANK CASING USED:
 1 Steel 3 RMP (SR) 5 Wrought iron 8 Concrete tile CASING JOINTS: Glued _____ Clamped _____
2 PVC 4 ABS 6 Asbestos-Cement 9 Other (specify below) Welded _____
 7 Fiberglass _____ Threaded
 Blank casing diameter **2** in. to **128** ft., Dia _____ in. to _____ ft., Dia _____ in. to _____ ft.
 Casing height above land surface **-4.56** in., weight _____ lbs./ft. Wall thickness or gauge No. **Sch. 40**
 TYPE OF SCREEN OR PERFORATION MATERIAL
 1 Steel 3 Stainless steel 5 Fiberglass **7** PVC 10 Asbestos-cement
 2 Brass 4 Galvanized steel 6 Concrete tile 8 RMP (SR) 11 Other (specify) _____
 9 ABS 12 None used (open hole)
 SCREEN OR PERFORATION OPENINGS ARE:
 1 Continuous slot **3** Mill slot 5 Gauzed wrapped 8 Saw cut 11 None (open hole)
 2 Louvered shutter 4 Key punched 6 Wire wrapped 9 Drilled holes
 7 Torch cut 10 Other (specify) _____
 SCREEN-PERFORATED INTERVALS: From **128** ft. to **158** ft., From _____ ft. to _____ ft.
 From _____ ft. to _____ ft., From _____ ft. to _____ ft.
 GRAVEL PACK INTERVALS: From **124** ft. to **160** ft., From _____ ft. to _____ ft.
 From _____ ft. to _____ ft., From _____ ft. to _____ ft.

6 GROUT MATERIAL: 1 Neat cement **2** Cement grout **3** Bentonite 4 Other _____
 Grout intervals: From **0** ft. to **120** ft., From **120** ft. to **124** ft., From _____ ft. to _____ ft.
 What is the nearest source of possible contamination:
 1 Septic tank 4 Lateral lines 7 Pit privy 10 Livestock pens 14 Abandoned water well
 2 Sewer lines 5 Cess pool 8 Sewage lagoon 11 Fuel storage 15 Oil well/Gas well
 3 Watertight sewer lines 6 Seepage pit 9 Feedyard 12 Fertilizer storage **16** Other (specify below)
 13 Insecticide storage **UST Basin**
 Direction from well? **NW** How many feet? **375**

FROM	TO	LITHOLOGIC LOG	FROM	TO	PLUGGING INTERVALS
0	2	Clay, Light Brown	146	160	Sand, Light Orange Brown
2	7	Clay, Dark Brown			
7	13	Clay, Light Brown			
13	18	Sand, Light Yellow Orange			
18	19	Sand, Bright Orange Brown			
19	24	Sand, Light Orange Brown			
24	28	Clay, Light Brown			
28	33	Sand, Light Orange Brown			
33	42	Clay, Light Orange Brown			
42	64	Clay, Light Orange Brown			
64	90	Clay, Medium Orange Brown			
90	101	Clay, Light Orange Brown			
101	124	Clay, Medium Orange Brown			MW9, Tag # 00116646, Flushmount
124	138	Clay, Light Orange Brown			Project Name: Weaver General Store
138	146	Caliche Bed,			GeoCore # 141, KDHE # U1 088 769

7 CONTRACTOR'S OR LANDOWNER'S CERTIFICATION: This water well was **1** constructed, **2** reconstructed, or **3** plugged under my jurisdiction and was completed on (mo/day/year) **9/30/95** and this record is true to the best of my knowledge and belief.
 Kansas Water Well Contractor's License No. **527** This Water Well Record was completed on (mo/day/yr) **10/30/95**
 under the business name of **GeoCore Services, Inc.** by (signature) *Dale Rall*

OFFICE USE ONLY

T

R

EW

SEC.

1/4

1/4

1/4