


1 LOCATION OF WATER WELL: County: <b>Seward</b>	Fraction <b>SW ¼ SW ¼ NW ¼</b>	Section Number <b>4</b>	Township Number <b>T 35 S</b>	Range Number <b>R 33</b>
--	-----------------------------------	----------------------------	----------------------------------	-----------------------------

Distance and direction from nearest town or city street address of well if located within city?

**20' East & 220' North of Pancake & Washington**

2 WATER WELL OWNER: <b>Weaver General Store</b> RR#, St. Address, Box # : <b>420 South Washington</b> City, State, ZIP Code : <b>Liberal, Kansas</b>	Board of Agriculture, Division of Water Resources Application Number:
--	--

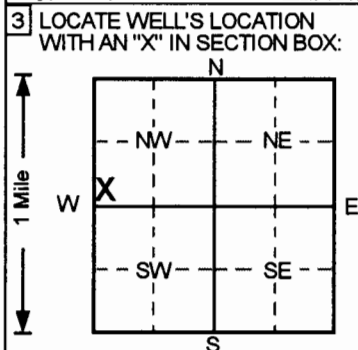

4 DEPTH OF COMPLETED WELL: <b>156</b> ft. ELEVATION: <b>2837.17</b>
Depth(s) Groundwater Encountered 1. .... ft. 2. .... ft. 3. .... ft.
WELL'S STATIC WATER LEVEL: <b>145.68</b> ft. below land surface measured on <b>mo/day/yr</b> <b>10/11/95</b>
Pump test data: Well water was <b>NA</b> ft. after .... hours pumping .... gpm
Est. Yield <b>NA</b> gpm: Well water was .... ft. after .... hours pumping .... gpm
Bore Hole Diameter <b>8</b> in. to <b>160</b> ft., and .... in. to .... ft.
WELL WATER TO BE USED AS:
5 Public water supply      8 Air conditioning      11 Injection well
1 Domestic      3 Feedlot      6 Oil field water supply      9 Dewatering      12 Other (Specify below)
2 Irrigation      4 Industrial      7 Lawn and garden only <b>10 Monitoring well</b>
Was a chemical/bacteriological sample submitted to Department? Yes.....No <b>✓</b> .....; If yes, mo/day/yr sample was submitted
Water Well Disinfected? Yes      No <b>✓</b>

5 TYPE OF BLANK CASING USED:	5 Wrought iron	8 Concrete tile	CASING JOINTS: Glued .... Clamped ....
1 Steel	3 RMP (SR)	6 Asbestos-Cement	9 Other (specify below)
<b>2 PVC</b>	4 ABS	7 Fiberglass	Welded ....
Blank casing diameter <b>2</b> in. to <b>126</b> ft., Dia. .... in. to .... ft., Dia. .... in. to .... ft.			Threaded. <b>✓</b>
Casing height above land surface <b>-3.84</b> in., weight .... lbs./ft. Wall thickness or gauge No. <b>Sch. 40</b>			
TYPE OF SCREEN OR PERFORATION MATERIAL	<b>7 PVC</b>	10 Asbestos-cement	
1 Steel	3 Stainless steel	5 Fiberglass	8 RMP (SR)
2 Brass	4 Galvanized steel	6 Concrete tile	9 ABS
SCREEN OR PERFORATION OPENINGS ARE:	5 Gauzed wrapped	8 Saw cut	11 None (open hole)
1 Continuous slot	<b>3 Mill slot</b>	6 Wire wrapped	9 Drilled holes
2 Louvered shutter	4 Key punched	7 Torch cut	10 Other (specify) ....
SCREEN-PERFORATED INTERVALS:	From <b>126</b> ft. to <b>156</b> ft., From .... ft. to .... ft.		
GRAVEL PACK INTERVALS:	From <b>120</b> ft. to <b>156</b> ft., From .... ft. to .... ft.		

6 GROUT MATERIAL:	1 Neat cement	<b>2 Cement grout</b>	<b>3 Bentonite</b>	4 Other
Grout Intervals: From <b>0</b> ft. to <b>116</b> ft., From <b>116</b> ft. to <b>120</b> ft., From .... ft. to .... ft.				
What is the nearest source of possible contamination:	1 Septic tank	4 Lateral lines	7 Pit privy	10 Livestock pens
	2 Sewer lines	5 Cess pool	8 Sewage lagoon	11 Fuel storage
	3 Watertight sewer lines	6 Seepage pit	9 Feedyard	12 Fertilizer storage
Direction from well? <b>SW</b>				13 Insecticide storage
				14 Abandoned water well
				15 Oil well/Gas well
				<b>16 Other (specify below)</b>
				<b>UST Basin</b>
				How many feet? <b>155</b>

FROM	TO	LITHOLOGIC LOG	FROM	TO	PLUGGING INTERVALS
0	2	Clay, Medium Brown	110	122	Clay, Medium Orange Brown
2	6	Clay, Medium Brown	122	138	Clay, Light Orange Brown
6	8	Clay, Dark Brown	138	146	Caliche Bed,
8	13	Clay, Light Brown	146	160	Sand, Light Orange Brown
13	18	Sand, Light Yellow Orange			
18	23	Clay, Medium Orange Brown			
23	27	Clay, Light Olive Brown			
27	35	Sand, Light Yellow Green			
35	42	Clay, Light Olive Brown			
42	55	Clay, Light Olive Green			
55	70	Clay, Light Brown			
70	92	Clay, Light Brown			
92	96	Clay, Light Brown			MW5, Tag # 00116370, Flushmount
96	100	Clay, Light Orange Brown			Project Name: Weaver General Store
100	110	Clay, Medium Orange Brown			GeoCore # 141, KDHE # U1 088 769

7 CONTRACTOR'S OR LANDOWNER'S CERTIFICATION: This water well was <b>(1)</b> constructed, (2) reconstructed, or (3) plugged under my jurisdiction and was completed on (mo/day/year) <b>9/30/95</b> and this record is true to the best of my knowledge and belief.
Kansas Water Well Contractor's License No. <b>527</b> This Water Well Record was completed on (mo/day/yr) <b>10/30/95</b> under the business name of <b>GeoCore Services, Inc.</b> by (signature) <i>Paul Bell</i>