

1 LOCATION OF WATER WELL: Fraction SE 1/4 SW 1/4 SE 1/4 Section Number 6 Township Number T 35 S Range Number R 33 E/W

Distance and direction from nearest town or city street address of well if located within city?

West 2nd Street Road - Liberal, KS

2 WATER WELL OWNER: Panhandle Eastern Liberal Maintenance Facility


RR#, St. Address, Box # : RR #1, Box 220

Board of Agriculture, Division of Water Resources

City, State, ZIP Code : Liberal, Kansas 67901

Application Number:

3 LOCATE WELL'S LOCATION WITH AN "X" IN SECTION BOX:

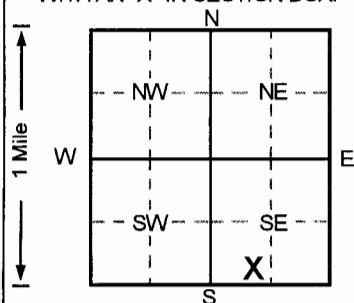

4 DEPTH OF COMPLETED WELL . . . . . 48 . . . . . ft. ELEVATION: . . . . . 2860.41

Depth(s) Groundwater Encountered 1. . . . . 999 . . . . . ft. 2. . . . . ft. 3. . . . . ft.

WELL'S STATIC WATER LEVEL . . . . . 999 . . . . . ft. below land surface measured on mo/day/yr

Pump test data: Well water was . . . . . NA . . . . . ft. after . . . . . hours pumping . . . . . gpm

Est. Yield . . . . . NA . . . . . gpm: Well water was . . . . . ft. after . . . . . hours pumping . . . . . gpm

Bore Hole Diameter . . . . . 8 . . . . . in. to . . . . . 80 . . . . . ft. and . . . . . in. to . . . . . ft.

WELL WATER TO BE USED AS: 5 Public water supply 8 Air conditioning 11 Injection well

1 Domestic 3 Feedlot 6 Oil field water supply 9 Dewatering 12 Other (Specify below)

2 Irrigation 4 Industrial 7 Lawn and garden only 10 Monitoring well Soil Vapor Extract.

Was a chemical/bacteriological sample submitted to Department? Yes.....No[checked]; If yes, mo/day/yr sample was submitted

Water Well Disinfected? Yes No [checked]

5 TYPE OF BLANK CASING USED:

1 Steel 3 RMP (SR) 5 Wrought iron 8 Concrete tile CASING JOINTS: Glued . . . . . Clamped . . . . .

2 PVC 4 ABS 6 Asbestos-Cement 9 Other (specify below) Welded . . . . .

Blank casing diameter . . . . . 2 . . . . . in. to . . . . . 38 . . . . . ft. Dia . . . . . in. to . . . . . ft. Dia . . . . . in. to . . . . . ft.

Casing height above land surface . . . . . 36 . . . . . in., weight . . . . . lbs./ft. Wall thickness or gauge No. . . . . Sch. 40

TYPE OF SCREEN OR PERFORATION MATERIAL (7) PVC 10 Asbestos-cement

1 Steel 3 Stainless steel 5 Fiberglass 8 RMP (SR) 11 Other (specify)

2 Brass 4 Galvanized steel 6 Concrete tile 9 ABS 12 None used (open hole)

SCREEN OR PERFORATION OPENINGS ARE:

1 Continuous slot 3 Mill slot 5 Gauzed wrapped 8 Saw cut 11 None (open hole)

2 Louvered shutter 4 Key punched 6 Wire wrapped 9 Drilled holes

SCREEN-PERFORATED INTERVALS: From . . . . . 38 . . . . . ft. to . . . . . 48 . . . . . ft.

GRAVEL PACK INTERVALS: From . . . . . 35 . . . . . ft. to . . . . . 48 . . . . . ft.

From . . . . . ft. to . . . . . ft. From . . . . . ft. to . . . . . ft.

From . . . . . ft. to . . . . . ft. From . . . . . ft. to . . . . . ft.

6 GROUT MATERIAL: 1 Neat cement 2 Cement grout 3 Bentonite 4 Other

Grout intervals: From . . . . . 3 . . . . . ft. to . . . . . 30 . . . . . ft. From . . . . . 30 . . . . . ft. to . . . . . 35 . . . . . ft.

What is the nearest source of possible contamination:

1 Septic tank 4 Lateral lines 7 Pit privy 10 Livestock pens 14 Abandoned water well

2 Sewer lines 5 Cess pool 8 Sewage lagoon 11 Fuel storage 15 Oil well/Gas well

3 Watertight sewer lines 6 Seepage pit 9 Feedyard 12 Fertilizer storage 16 Other (specify below)

Direction from well? S How many feet? 55

Table with columns: FROM, TO, LITHOLOGIC LOG, FROM, TO, PLUGGING INTERVALS. Includes entries for Soil, Clay/Silt, Sand, and Bentonite.

7 CONTRACTOR'S OR LANDOWNER'S CERTIFICATION: This water well was (1) constructed, (2) reconstructed, or (3) plugged under my jurisdiction and was completed on (mo/day/year) 5/13/96 and this record is true to the best of my knowledge and belief. Kansas Water Well Contractor's License No. 527 This Water Well Record was completed on (mo/day/yr) 6/12/96 under the business name of GeoCore Services, Inc. by (signature) Dan Rold