


LOCATION OF WATER WELL: County: SEWARD Fraction: NE 1/4 NE 1/4 NW 1/4 Section Number: 06 Township Number: T 35 S Range Number: R 33 EW

Distance and direction from nearest town or city street address of well if located within city?  
521 AIRPORT, LIBERAL, KS

2 WATER WELL OWNER: CITY OF LIBERAL  
 RR#, St. Address, Box #: P.O. BOX 2199  
 City, State, ZIP Code: LIBERAL, KS 67901  
 Board of Agriculture, Division of Water Resources  
 Application Number:

3 LOCATE WELL'S LOCATION WITH AN "X" IN SECTION BOX: 4 DEPTH OF COMPLETED WELL: 140 ft. ELEVATION: 2861.13  
 Depth(s) Groundwater Encountered 1. 128 ft. 2. ft. 3. ft.  
 WELL'S STATIC WATER LEVEL 129.46 ft. below land surface measured on mo/day/yr 03/05/97

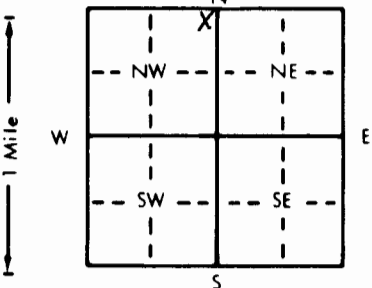

Pump test data: Well water was ft. after hours pumping gpm  
 Est. Yield gpm: Well water was ft. after hours pumping gpm  
 Bore Hole Diameter: 8 in. to 150 ft. and in. to ft.  
 WELL WATER TO BE USED AS:  
 1 Domestic 2 Irrigation 3 Feedlot 4 Industrial 5 Public water supply 6 Oil field water supply 7 Lawn and garden only 8 Air conditioning 9 Dewatering 10 Monitoring well 11 Injection well 12 Other (Specify below)  
 Was a chemical/bacteriological sample submitted to Department? Yes No X If yes, mo/day/yr sample was submitted  
 Water Well Disinfected? Yes No

5 TYPE OF BLANK CASING USED:  
 1 Steel 2 PVC 3 RMP (SR) 4 ABS 5 Wrought iron 6 Asbestos-Cement 7 Fiberglass 8 Concrete tile 9 Other (specify below) 10 Asbestos-cement 11 Other (specify) 12 None used (open hole)  
 CASING JOINTS: Glued Clamped Welded Threaded  
 Blank casing diameter: 2 in. to 110 ft., Dia. in. to ft., Dia. in. to ft.  
 Casing height above land surface: 252 in., weight 2.071 lbs./ft. Wall thickness or gauge No. 0.237

TYPE OF SCREEN OR PERFORATION MATERIAL:  
 1 Steel 2 Brass 3 Stainless steel 4 Galvanized steel 5 Fiberglass 6 Concrete tile 7 Torch cut 8 RMP (SR) 9 ABS 10 Asbestos-cement 11 Other (specify) 12 None used (open hole)

SCREEN OR PERFORATION OPENINGS ARE:  
 1 Continuous slot 2 Louvered shutter 3 3 Mill slot 4 Key punched 5 Gauzed wrapped 6 Wire wrapped 7 Torch cut 8 Saw cut 9 Drilled holes 10 Other (specify) 11 None (open hole)

SCREEN-PERFORATED INTERVALS: From 110 ft. to 140 ft., From ft. to ft., From ft. to ft.  
 GRAVEL PACK INTERVALS: From 107 ft. to 150 ft., From ft. to ft., From ft. to ft.

6 GROUT MATERIAL: 1 Neat cement 2 Cement grout 3 Bentonite 4 Other  
 Grout Intervals: From 1 ft. to 107 ft., From ft. to ft., From ft. to ft., From ft. to ft.

What is the nearest source of possible contamination:  
 1 Septic tank 2 Sewer lines 3 Watertight sewer lines 4 Lateral lines 5 Cess pool 6 Seepage pit 7 Pit privy 8 Sewage lagoon 9 Feedyard 10 Livestock pens 11 Fuel storage 12 Fertilizer storage 13 Insecticide storage 14 Abandoned water well 15 Oil well/Gas well 16 Other (specify below)  
 Direction from well? N/A How many feet? 0

FROM	TO	LITHOLOGIC LOG	FROM	TO	PLUGGING INTERVALS
0	10	SILTY CLAY			
10	15	SAND			
15	20	SILTY CLAY			
20	70	SAND			
70	130	SILTY CLAY			
130	132	SANDY SILT			

7 CONTRACTOR'S OR LANDOWNER'S CERTIFICATION: This water well was (1) constructed, (2) reconstructed, or (3) plugged under my jurisdiction and was completed on (mo/day/year) 02/10/97 and this record is true to the best of my knowledge and belief. Kansas Water Well Contractor's License No. 574 This Water Well Record was completed on (mo/day/yr) 04/12/97 under the business name of CORANCO INC by (signature) [Signature]