


1	LOCATION OF WATER WELL:	Fraction	Section Number	Township Number	Range Number
County:	<u>SEWARD</u>	<u>SE 1/4 SW 1/4 SE 1/4</u>	<u>6</u>	<u>35 5</u>	<u>33 W</u>

Distance and direction from nearest town or city street address of well if located within city?

2 WATER WELL OWNER: TRC ENVIRONMENTAL CORP
2313 W. Sam Houston Hwy STE 107
 RR #, St. Address, Box #: _____
 City, State, ZIP Code : HOUSTON TX 77043
 Board of Agriculture, Division of Water Resources
 Application Number: _____

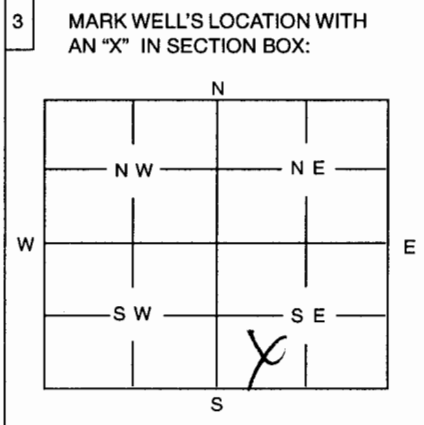

4 DEPTH OF WELL 122.7 ft
 WELL'S STATIC WATER LEVEL _____ ft.
 WELL WAS USED AS:
 1 Domestic 5 Public Water Supply 9 Dewatering
 2 Irrigation 6 Oil Field Water Supply 10 Monitoring Well OB-3
 3 Feedlot 7 Domestic (Lawn & Garden) 11 Injection Well MIDDLE
 4 Industrial 8 Air Conditioning 12 Other _____

Was a chemical / bacteriological sample submitted to Department? Yes _____ No X
 If yes, mo/day/yr sample was submitted _____

Water Well Disinfected: Yes _____ No _____

5 TYPE OF BLANK CASING USED:

1 Steel 3 RMP (SR) 5 Wrought 7 Fiberglass 9 Other (Specify below)
2 PVC 4 ABS 6 Asbestos-Cement 8 Concrete Tile

Blank casing diameter 2 in. Was casing pulled? Yes _____ No X If yes, how much _____
 Casing height above or below land surface _____ in.

6 GROUT PLUG MATERIAL: 1 Neat cement 2 Cement grout 3 Bentonite 4 Other _____

Grout Plug Intervals: From _____ ft. to _____ ft., From _____ ft. to _____ ft., From _____ ft. to _____ ft.

What is the nearest source of possible contamination:

1 Septic tank	6 Seepage pit	11 Fuel storage	16 Other (specify below)
2 Sewer lines	7 Pit privy	12 Fertilizer storage	
3 Watertight sewer lines	8 Sewage lagoon	13 Insecticide storage	
4 Lateral lines	9 Feedyard	14 Abandoned water well	
5 Cess Pool	10 Livestock pens	15 Oil well/Gas well	

Direction from well? _____ How many feet? _____

FROM	TO	PLUGGING MATERIALS
<u>122.7</u>	<u>0</u>	<u>Cement grout</u>

7 CONTRACTOR'S OR LANDOWNER'S CERTIFICATION: This water well was plugged under my jurisdiction and was completed on (mo/day/year) 9/7/04 and this record is true to the best of my knowledge and belief. Kansas Water Well Contractor's License No. 729 This Water Well Record was completed on (mo/day/year) 11/1/04 under the business name of SPRING WATER MONITORING by (signature) [Signature]

INSTRUCTIONS: Use typewriter or ball point pen. Please press firmly and print clearly. Please fill in blanks, underline or circle the correct answers. Send top three copies to Kansas Department of Health and Environment, Bureau of Water, Topeka, Kansas 66620-0001. Telephone: 785/296-3565. Send one to Water Well Owner and retain one for your records.