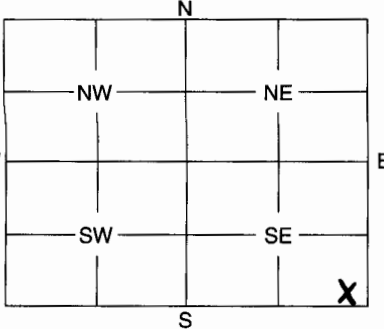


1	LOCATION OF WATER WELL:	Fraction	Section Number	Township Number	Range Number
County:	Seward	SE 1/4 SE 1/4 SE 1/4	16	35S	33W E/W

Distance and direction from nearest town or city street address of well if located within city?
 Liberal: 83/CR J--1 S to state line--600' W and N into--


2	WATER WELL OWNER:	Raydon Expl. Co. Inc.	#1-16 Kanco
	RR #, St. Address, Box #:	9400 N Broadway, Ste. 400	
	City, State, ZIP Code :	Oklahoma City, OK 73114	Board of Agriculture, Division of Water Resources Application Number: 20050080

3	MARK WELL'S LOCATION WITH AN "X" IN SECTION BOX:	4	DEPTH OF WELL300..... ft.
			WELL'S STATIC WATER LEVEL140..... ft.
			WELL WAS USED AS:
			1 Domestic 2 Irrigation 3 Feedlot 4 Industrial 5 Public Water Supply 6 Oil Field Water Supply 7 Domestic (Lawn & Garden) 8 Air Conditioning 9 Dewatering 10 Monitoring Well 11 Injection Well 12 Other
			Was a chemical / bacteriological sample submitted to Department? Yes No <u>X</u> If yes, mo/day/yr sample was submitted
			Water Well Disinfected: Yes <u>X</u> No

5	TYPE OF BLANK CASING USED:
	1 Steel 2 PVC 3 RMP (SR) 4 ABS 5 Wrought 6 Asbestos-Cement 7 Fiberglass 8 Concrete Tile 9 Other (Specify below)
	Blank casing diameter6..... in. Was casing pulled? Yes No <u>X</u> If yes, how much
	Casing height above or below land surface36..... in.

6	GROUT PLUG MATERIAL:	1 Neat cement	2 Cement grout	3 Bentonite	4 Other
	GROUT PLUG INTERVALS:	From130..... ft. to3..... ft.,	Fromft. toft.,	From to ft.	
	What is the nearest source of possible contamination:				
	1 Septic tank 2 Sewer lines 3 Watertight sewer lines 4 Lateral lines 5 Cess pool 6 Seepage pit 7 Pit privy 8 Sewage lagoon 9 Feedyard 10 Livestock pens 11 Fuel storage 12 Fertilizer storage 13 Insecticide storage 14 Abandoned water well 15 Oil well/Gas well 16 Other (specify below)				
	Direction from well?Northwest.....	How many feet?300.....			

FROM	TO	PLUGGING MATERIALS
300	140	Chlorinated Gravel
140	130	Hole Plug
130	3	Cement Grout
3	0	Backfill

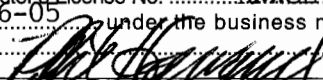7	CONTRACTOR'S OR LANDOWNER'S CERTIFICATION: This water well was plugged under my jurisdiction and was completed on (mo/day/year) 04-26-05 and this record is true to the best of my knowledge and belief. Kansas Water Well Contractor's License No. KWWCL-430 This Water Well Record was completed on (mo/day/year) 04-26-05 under the business name of Howard Drilling Co. Box 806 Beaver, OK 73932 by (signature) 
---	---

INSTRUCTIONS: Use typewriter or ball point pen. Please press firmly and print clearly. Please fill in blanks, underline or circle the correct answers. Send top three copies to Kansas Department of Health and Environment, Bureau of Water, Geology Section, 1000 SW Jackson St., Ste. 420, Topeka, Kansas 66612-1367. Telephone: 785/296-5522. Send one to Water Well Owner and retain one for your records.