


1 LOCATION OF WATER WELL: County: Seward Fraction SE 1/4 NW 1/4 SW 1/4 Section Number 5 Township Number 35 Range Number 33 **EW**

Distance and direction from nearest town or city street address of well if located within city?

1100 W. Pancake Dr. Liberal, KS

2 WATER WELL OWNER: Halliburton Energy
 RR#, St. Address, Box #: 10200 Bellaire Blvd
 City, State ZIP Code: Houston, TX 77052-520
 Global Positioning Systems (decimal degrees, min. of 4 digits)
 Latitude: 37°N, 1.89'
 Longitude: 100°W, 58.98'
 Elevation: 2847'
 Datum: NAD 27
 Data Collection Method: USGS Topo map

3 MARK WELL'S LOCATION WITH AN "X" IN SECTION BOX:

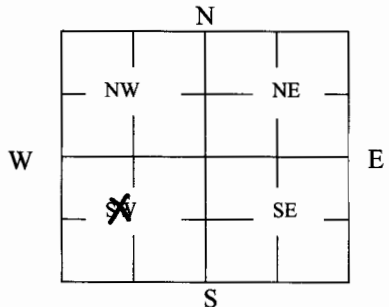

4 DEPTH OF WELL 200 ft.

WELL'S STATIC WATER LEVEL 152-29 ft

WELL WAS USED AS:

- | | | |
|--------------|----------------------------|----------------------|
| 1 Domestic | 5 Public Water Supply | 9 Dewatering |
| 2 Irrigation | 6 Oil Field Water Supply | <u>10</u> Monitoring |
| 3 Feedlot | 7 Domestic (Lawn & Garden) | 11 Injection Well |
| 4 Industrial | 8 Air Conditioning | 12 Other _____ |

Was a chemical/bacteriological sample submitted to Department? Yes _____ No X

5 TYPE OF BLANK CASING USED:

<u>1</u> Steel	3 RMP (SR)	5 Wrought	7 Fiberglass	9 Other (Specify below)
<u>2</u> PVC	4 ABS	6 Asbestos-Cement	8 Concrete Tile	

Blank casing diameter 4 in. Was casing pulled? Yes X No _____ If yes, how much 3'
 Casing height above or below land surface 36 in.

6 GROUT PLUG MATERIAL: 1 Neat cement 2 Cement grout 3 Bentonite 4 Other _____

Grout Plug Intervals: From 200 ft. to 3 ft., From _____ ft. to _____ ft., From _____ to _____ ft.

What is the nearest source of possible contamination:

- | | | | |
|--------------------------|-------------------|-------------------------|-----------------------------------|
| 1 Septic tank | 6 Seepage pit | <u>11</u> Fuel Storage | 16 Other (specify below) |
| 2 Sewer lines | 7 Pit privy | 12 Fertilizer storage | |
| 3 Watertight sewer lines | 8 Sewage lagoon | 13 Insecticide storage | |
| 4 Lateral lines | 9 Feedyard | 14 Abandoned water well | Direction from well? <u>South</u> |
| 5 Cess pool | 10 Livestock pens | 15 Oil well/Gas well | How many feet? <u>100'</u> |

FROM	TO	PLUGGING MATERIALS	FROM	TO	PLUGGING MATERIALS
<u>200</u>	<u>3</u>	<u>Bentonite</u>			
<u>3</u>	<u>0</u>	<u>native surface</u>			

7 CONTRACTOR'S OR LANDOWNER'S CERTIFICATION: This water well was plugged under my jurisdiction and was completed on (mo/day/year) 9/19/06 and this record is true to the best of my knowledge and belief, Kansas Water Well Contractor's License No. 594. This Water Well Record was completed on (mo/day/year) 9/25/06 under the business name of Coranco Great Plains, Inc by (signature) Timothy J. Muhl