


1 LOCATION OF WATER WELL: County: Seward Fraction: SE 1/4 NW 1/4 SW 1/4 Section Number: 5 Township Number: 35 Range Number: 33 EW

Distance and direction from nearest town or city street address of well if located within city?

1100 W. Pancake Dr. Liberal, KS

2 WATER WELL OWNER: Halliburton Energy Global Positioning Systems (decimal degrees, min. of 4 digits)  
 RR#, St. Address, Box #: 10200 Bellaire Blvd Latitude: 37°N, 1.89'  
 City, State ZIP Code: Houston, Tx 77052-520 Longitude: 100°W, 55.98'  
 Elevation: 2847  
 Datum: NAD 27  
 Data Collection Method: USGS Topo maps

3 MARK WELL'S LOCATION WITH AN "X" IN SECTION BOX:

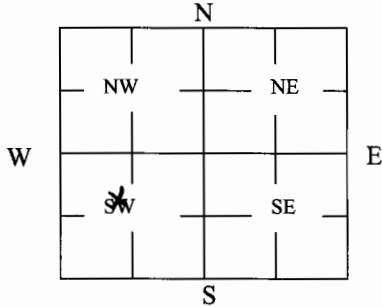

4 DEPTH OF WELL 200 ft.

WELL'S STATIC WATER LEVEL 152.45 ft

WELL WAS USED AS:

- 1 Domestic
- 2 Irrigation
- 3 Feedlot
- 4 Industrial
- 5 Public Water Supply
- 6 Oil Field Water Supply
- 7 Domestic (Lawn & Garden)
- 8 Air Conditioning
- 9 Dewatering
- 10  Monitoring
- 11 Injection Well
- 12 Other \_\_\_\_\_

Was a chemical/bacteriological sample submitted to Department? Yes \_\_\_\_\_ No

5 TYPE OF BLANK CASING USED:  
 1 Steel    3 RMP (SR)    5 Wrought    7 Fiberglass    9 Other (Specify below)  
 2  PVC    4 ABS    6 Asbestos-Cement    8 Concrete Tile

Blank casing diameter 4 in. Was casing pulled? Yes  No \_\_\_\_\_ If yes, how much 3'  
 Casing height above or below land surface 36 in.

6 GROUT PLUG MATERIAL: 1 Neat cement    2 Cement grout    3  Bentonite    4 Other \_\_\_\_\_

Grout Plug Intervals: From 200 ft. to 3 ft., From \_\_\_\_\_ ft. to \_\_\_\_\_ ft., From \_\_\_\_\_ to \_\_\_\_\_ ft.

What is the nearest source of possible contamination:

- 1 Septic tank
  - 2 Sewer lines
  - 3 Watertight sewer lines
  - 4 Lateral lines
  - 5 Cess pool
  - 6 Seepage pit
  - 7 Pit privy
  - 8 Sewage lagoon
  - 9 Feedyard
  - 10 Livestock pens
  - 11  Fuel Storage
  - 12 Fertilizer storage
  - 13 Insecticide storage
  - 14 Abandoned water well
  - 15 Oil well/Gas well
  - 16 Other (specify below) \_\_\_\_\_
- Direction from well? SE  
 How many feet? 75

FROM	TO	PLUGGING MATERIALS	FROM	TO	PLUGGING MATERIALS
<u>200</u>	<u>3</u>	<u>Bentonite</u>			
<u>3</u>	<u>0</u>	<u>native surface</u>			

7 CONTRACTOR'S OR LANDOWNER'S CERTIFICATION: This water well was plugged under my jurisdiction and was completed on (mo/day/year) 9/19/06 and this record is true to the best of my knowledge and belief. Kansas Water Well Contractor's License No. 594. This Water Well Record was completed on (mo/day/year) 9/25/06 under the business name of Covanco Great Plains, Inc by (signature) [Signature]

INSTRUCTIONS: Use typewriter or ballpoint pen. Please press firmly and print clearly. Please fill in blanks, underline or circle the correct answers. Send top three copies to Kansas Department of Health and Environment, Bureau of Water, Geology Section, 1000 SW Jackson St., Ste. 420, Topeka, Kansas 66612-1367. Telephone: 785/296-5522. Send one to Water Well Owner and retain one for your records. Visit us at <http://www.kdheks.gov/geo/waterwells>.