


1 LOCATION OF WATER WELL: Fraction SE 1/4 SW 1/4 NE 1/4 Section Number 5 Township Number T 35 S Range Number R 33 E/W
 County: Seward
 Location from nearest town or city street address of well if located within city?
Love's Country Store #24 - Liberal

2 WATER WELL OWNER: Love's Country Stores Inc
 RR#, St. Address, Box #: PO Box 26210 Board of Agriculture, Division of Water Resources
 City, State, ZIP Code: Oklahoma City OK 73126 Application Number: Mw-7R

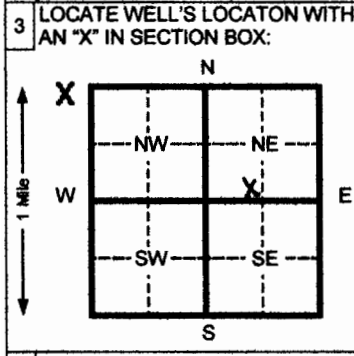

4 DEPTH OF COMPLETED WELL 200 ft. ELEVATION: _____
 Depth(s) Groundwater Encountered 1 _____ ft. 2 _____ ft. 3 _____ ft.
 WELL'S STATIC WATER LEVEL 170 ft. below land surface measured on mo/day/yr
 Pump test data: Well water was _____ ft. after _____ hours pumping _____ gpm
 Est. Yield _____ gpm: Well water was _____ ft. after _____ hours pumping _____ gpm
 Bore Hole Diameter 8 in. to 205 ft. and _____ in. to _____ ft.
 WELL WATER TO BE USED AS:
 1 Domestic 2 Irrigation 3 Feed lot 4 Industrial 5 Public water supply 6 Oil field water supply 7 Lawn and garden (domestic) 8 Air conditioning 9 Dewatering 10 Monitoring well 11 Injection well 12 Other (Specify below)
 Was a chemical/bacteriological sample submitted to Department? Yes _____ No X If yes, mo/day/yr sample was submitted _____
 Water Well Disinfected? Yes _____ No X

5 TYPE OF BLANK CASING USED:
 1 Steel 2 PVC 3 RMP (SR) 4 ABS 5 Wrought Iron 6 Asbestos-Cement 7 Fiberglass 8 Concrete tile 9 Other (specify below)
 Blank casing diameter 4 in. to 150 ft. Dia _____ in. to _____ ft. Dia _____ in. to _____ ft.
 Casing height above land surface _____ in., weight 2.071 lbs./ft. Wall thickness or gauge No. 237
 TYPE OF SCREEN OR PERFORATION MATERIAL:
 1 Steel 2 Brass 3 Stainless steel 4 Galvanized steel 5 Fiberglass 6 Concrete tile 7 PVC 8 RMP (SR) 9 ABS 10 Asbestos-cement 11 Other (specify)
 SCREEN OR PERFORATION OPENINGS ARE:
 1 Continuous slot 2 Louvered shutter 3 Mill slot 4 Key punched 5 Gauzed wrapped 6 Wire wrapped 7 Torch cut 8 Saw cut 9 Drilled holes 10 Other (specify) 11 None (open hole)
 SCREEN-PERFORATED INTERVALS: From 150 ft. to 200 ft. From _____ ft. to _____ ft.
 GRAVEL PACK INTERVALS: From 145 ft. to 200 ft. From _____ ft. to _____ ft.

6 GROUT MATERIAL: 1 Neat cement 2 Cement grout 3 Bentonite 4 Other
 Grout Intervals From 0 ft. to 143 ft. From 143 ft. to 145 ft. From _____ ft. to _____ ft.
 What is the nearest source of possible contamination:
 1 Septic tank 2 Sewer lines 3 Watertight sewer lines 4 Lateral lines 5 Cess pool 6 Seepage pit 7 Pit privy 8 Sewage lagoon 9 Feedyard 10 Livestock pens 11 Fuel storage 12 Fertilizer storage 13 Insecticide storage 14 Abandoned water well 15 Oil well/ Gas well 16 Other (specify below)
Contaminated site
 Direction from well? _____ How many feet? _____

FROM	TO	CODE	LITHOLOGIC LOG	FROM	TO	PLUGGING INTERVALS
0	.5		Asphalt	105	140	Clay w/caliche lenses
.5	3		Fill sand	140	178	Caliche w/clay strks
3	13		Clay	178	183	Caliche w/sand strks
13	18		Fine sand w/clay & caliche	183	205	Fine to med sd w/caliche strks & clay strks
18	23		Sandy clay w/clay strks			
23	30		Clay & caliche			
30	35		Sandy clay w/clay			
35	60		Clay & caliche w/sandy clay strk			
60	67		Sandy clay w/fine sand strks			
67	78		Caliche & clay w/sandy clay strk			
78	87		Fine to some med sd w/caliche lenses			
87	100		Clay w/caliche lenses			
100	105		Fine sand w/caliche			

7 CONTRACTOR'S OR LANDOWNER'S CERTIFICATION: This water well was (1) constructed, (2) reconstructed, or (3) plugged under my jurisdiction and was completed on (mo/day/yr) 09-27-07 9-27-07 and this record is true to the best of my knowledge and belief. Kansas Water Well Contractor's License No. 554 This Water Well Record was completed on (mo/day/yr) 10-05-07 under the business name of Woofter Pump & Well Inc. by (signature) Thur Woofter

OFFICE USE ONLY

T
R

SEC