


1 LOCATION OF WATER WELL: County: Seward Fraction: NE 1/4 NW 1/4 SE 1/4 Section Number: 5 Township Number: T 35 S Range Number: R 33 E/W

Distance and direction from nearest town or city street address of well if located within city?

2 WATER WELL OWNER: Loves Country Store
 RR#, St. Address, Box #: P.O. Box 26210
 City, State, ZIP Code: Oklahoma City, OK 73126 Board of Agriculture, Division of Water Resources
 Application Number: MW2

3 LOCATE WELL'S LOCATION WITH AN "X" IN SECTION BOX: 4 DEPTH OF COMPLETED WELL: 180 ft. ELEVATION: _____

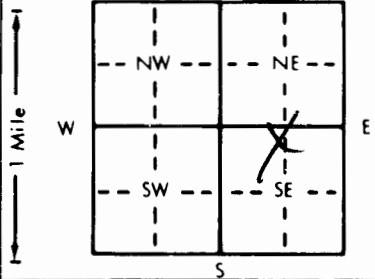

Depth(s) Groundwater Encountered 1. _____ ft. 2. _____ ft. 3. _____ ft.
 WELL'S STATIC WATER LEVEL: 146.13 ft. below land surface measured on mo/day/yr
 Pump test data: Well water was _____ ft. after _____ hours pumping _____ gpm
 Est. Yield _____ gpm: Well water was _____ ft. after _____ hours pumping _____ gpm
 Bore Hole Diameter: 8 in. to 180 ft., and _____ in. to _____ ft.
 WELL WATER TO BE USED AS:
 1 Domestic 3 Feedlot 6 Oil field water supply 8 Air conditioning 11 Injection well
 2 Irrigation 4 Industrial 7 Lawn and garden only 9 Dewatering 12 Other (Specify below)
 10 Monitoring well
 Was a chemical/bacteriological sample submitted to Department? Yes _____ No X If yes, mo/day/yr sample was submitted _____
 Water Well Disinfected? Yes _____ No X

5 TYPE OF BLANK CASING USED:
 1 Steel 3 RMP (SR) 5 Wrought iron 8 Concrete tile CASING JOINTS: Glued _____ Clamped _____
 2 PVC 4 ABS 6 Asbestos-Cement 9 Other (specify below) Welded _____
 7 Fiberglass Threaded X

Blank casing diameter: _____ in. to _____ in. Dia. _____ ft. Dia. _____ in. to _____ ft.
 Casing height above land surface: _____ in., weight 2.071 lbs./ft. Wall thickness or gauge No. 1231

TYPE OF SCREEN OR PERFORATION MATERIAL:
 1 Steel 3 Stainless steel 5 Fiberglass 7 PVC 10 Asbestos-cement
 2 Brass 4 Galvanized steel 6 Concrete tile 8 RMP (SR) 11 Other (specify) _____
 12 None used (open hole)

SCREEN OR PERFORATION OPENINGS ARE:
 1 Continuous slot 3 Mill slot 5 Gauzed wrapped 8 Saw cut 11 None (open hole)
 2 Louvered shutter 4 Key punched 6 Wire wrapped 9 Drilled holes
 7 Torch cut 10 Other (specify) _____

SCREEN-PERFORATED INTERVALS: From 150 ft. to 180 ft. From _____ ft. to _____ ft.
 From _____ ft. to _____ ft. From _____ ft. to _____ ft.
 GRAVEL PACK INTERVALS: From 148 ft. to 180 ft. From _____ ft. to _____ ft.
 From _____ ft. to _____ ft. From _____ ft. to _____ ft.

6 GROUT MATERIAL: 1 Neat cement 2 Cement grout 3 Bentonite 4 Other
 Grout Intervals: From 0 ft. to 140 ft. From 140 ft. to 148 ft. From _____ ft. to _____ ft.

What is the nearest source of possible contamination:
 1 Septic tank 4 Lateral lines 7 Pit privy 10 Livestock pens 14 Abandoned water well
 2 Sewer lines 5 Cess pool 8 Sewage lagoon 11 Fuel storage 15 Oil well/Gas well
 3 Watertight sewer lines 6 Seepage pit 9 Feedyard 12 Fertilizer storage 16 Other (specify below) contaminated site
 13 Insecticide storage

Direction from well? _____ How many feet? _____

FROM	TO	LITHOLOGIC LOG	FROM	TO	PLUGGING INTERVALS
0	2	Surface	99	119	Clay & Caliche strks w/ a few sand strks
2	19	Silty sand			
19	39	Silty sand w/ clay strks	119	131	Clay & Caliche strks
39	48	Sandy clay w/ sand strks	131	137	Clay
48	58	Sandy clay w/ caliche strks	137	138	Caliche
58	59	Clay & Caliche	138	180	Caliche w/ a few clay strks
59	66	fine sand			
66	68	Sandy clay			
68	71	caliche			
71	73	Clay & Caliche			
73	80	caliche			
80	93	fine sand w/ clay layers			
93	97	Clay			
97	99	caliche			
		Clay & Caliche			

7 CONTRACTOR'S OR LANDOWNER'S CERTIFICATION: This water well was (1) constructed, (2) reconstructed, or (3) plugged under my jurisdiction and was completed on (mo/day/year) 3-1-98 and this record is true to the best of my knowledge and belief. Kansas Water Well Contractor's License No. 354 This Water Well Record was completed on (mo/day/yr) 5-28-98 under the business name of Woofter Pumps & Well, Inc by (signature) Jay C. Woofter