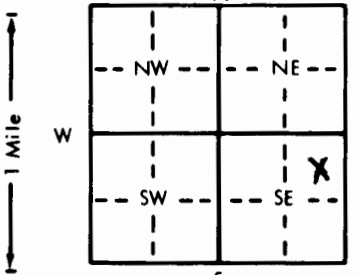


Lease:

1 LOCATION OF WATER WELL: Fraction 1/4 NE 1/4 SE 1/4 Section Number 9 Township Number T 35 S Range Number R 33 E/W  
 County: Seward  
 Distance and direction from nearest town or city street address of well if located within city? From Liberal go Southeast on Hwy 83 1/2 mi north and west into location.

2 WATER WELL OWNER: C&R Ins.  
 RR#, St. Address, Box #: Box 446 Board of Agriculture, Division of Water Resources  
 City, State, ZIP Code: Liberal, Kansas 67901 Application Number:

3 LOCATE WELL'S LOCATION WITH AN "X" IN SECTION BOX:  4 DEPTH OF COMPLETED WELL: 280 ft. ELEVATION:  
 Depth(s) Groundwater Encountered 1. 144 ft. 2. \_\_\_\_\_ ft. 3. \_\_\_\_\_ ft.  
 WELL'S STATIC WATER LEVEL 136 ft. below land surface measured on mo/day/yr 11/11/83  
 Pump test data: Well water was \_\_\_\_\_ ft. after \_\_\_\_\_ hours pumping \_\_\_\_\_ gpm  
 Est. Yield 60 gpm: Well water was \_\_\_\_\_ ft. after \_\_\_\_\_ hours pumping \_\_\_\_\_ gpm  
 Bore Hole Diameter 9 in. to 280 ft., and \_\_\_\_\_ in. to \_\_\_\_\_ ft.  
 WELL WATER TO BE USED AS:  
 1 Domestic \_\_\_\_\_ 2 Irrigation \_\_\_\_\_ 3 Feedlot \_\_\_\_\_ 4 Industrial \_\_\_\_\_  
 5 Public water supply \_\_\_\_\_ 6 Oil field water supply \_\_\_\_\_ 7 Lawn and garden only \_\_\_\_\_  
 8 Air conditioning \_\_\_\_\_ 9 Dewatering \_\_\_\_\_ 10 Observation well \_\_\_\_\_  
 11 Injection well \_\_\_\_\_ 12 Other (Specify below) \_\_\_\_\_  
 Was a chemical/bacteriological sample submitted to Department? Yes \_\_\_\_\_ No \_\_\_\_\_; If yes, mo/day/yr sample was submitted \_\_\_\_\_  
 Water Well Disinfected? Yes \_\_\_\_\_ No \_\_\_\_\_

5 TYPE OF BLANK CASING USED:  
 1 Steel \_\_\_\_\_ 2 PVC \_\_\_\_\_ 3 RMP (SR) \_\_\_\_\_ 4 ABS \_\_\_\_\_  
 5 Wrought iron \_\_\_\_\_ 6 Asbestos-Cement \_\_\_\_\_ 7 Fiberglass \_\_\_\_\_  
 8 Concrete tile \_\_\_\_\_ 9 Other (specify below) \_\_\_\_\_  
 CASING JOINTS: Glued \_\_\_\_\_ Clamped \_\_\_\_\_  
 \_\_\_\_\_ Welded \_\_\_\_\_  
 \_\_\_\_\_ Threaded \_\_\_\_\_  
 Blank casing diameter 5 in. to 220 ft., Dia \_\_\_\_\_ in. to \_\_\_\_\_ ft., Dia \_\_\_\_\_ in. to \_\_\_\_\_ ft.  
 Casing height above land surface 28 in., weight 2.78 lbs./ft. Wall thickness or gauge No. 256  
 TYPE OF SCREEN OR PERFORATION MATERIAL:  
 1 Steel \_\_\_\_\_ 2 Brass \_\_\_\_\_ 3 Stainless steel \_\_\_\_\_ 4 Galvanized steel \_\_\_\_\_  
 5 Fiberglass \_\_\_\_\_ 6 Concrete tile \_\_\_\_\_ 7 PVC \_\_\_\_\_ 8 RMP (SR) \_\_\_\_\_  
 10 Asbestos-cement \_\_\_\_\_ 11 Other (specify) \_\_\_\_\_  
 12 None used (open hole) \_\_\_\_\_  
 SCREEN OR PERFORATION OPENINGS ARE:  
 1 Continuous slot \_\_\_\_\_ 2 Louvered shutter \_\_\_\_\_ 3 Mill slot \_\_\_\_\_ 4 Key punched \_\_\_\_\_  
 5 Gauzed wrapped \_\_\_\_\_ 6 Wire wrapped \_\_\_\_\_ 7 Torch cut \_\_\_\_\_  
 8 Saw cut \_\_\_\_\_ 9 Drilled holes \_\_\_\_\_ 11 None (open hole) \_\_\_\_\_  
 10 Other (specify) \_\_\_\_\_  
 SCREEN-PERFORATED INTERVALS: From 220 ft. to 280 ft., From \_\_\_\_\_ ft. to \_\_\_\_\_ ft.  
 From \_\_\_\_\_ ft. to \_\_\_\_\_ ft., From \_\_\_\_\_ ft. to \_\_\_\_\_ ft.  
 GRAVEL PACK INTERVALS: From 100 ft. to 280 ft., From \_\_\_\_\_ ft. to \_\_\_\_\_ ft.  
 From \_\_\_\_\_ ft. to \_\_\_\_\_ ft., From \_\_\_\_\_ ft. to \_\_\_\_\_ ft.

6 GROUT MATERIAL: 1 Neat cement \_\_\_\_\_ 2 Cement grout \_\_\_\_\_ 3 Bentonite \_\_\_\_\_ 4 Other \_\_\_\_\_  
 Grout Intervals: From 0 ft. to 10 ft., From \_\_\_\_\_ ft. to \_\_\_\_\_ ft., From \_\_\_\_\_ ft. to \_\_\_\_\_ ft.  
 What is the nearest source of possible contamination: None  
 1 Septic tank \_\_\_\_\_ 2 Sewer lines \_\_\_\_\_ 3 Watertight sewer lines \_\_\_\_\_  
 4 Lateral lines \_\_\_\_\_ 5 Cess pool \_\_\_\_\_ 6 Seepage pit \_\_\_\_\_  
 7 Pit privy \_\_\_\_\_ 8 Sewage lagoon \_\_\_\_\_ 9 Feedyard \_\_\_\_\_  
 10 Livestock pens \_\_\_\_\_ 11 Fuel storage \_\_\_\_\_ 12 Fertilizer storage \_\_\_\_\_  
 13 Insecticide storage \_\_\_\_\_ 14 Abandoned water well \_\_\_\_\_ 15 Oil well/Gas well \_\_\_\_\_  
 16 Other (specify below) \_\_\_\_\_

Direction from well? \_\_\_\_\_ How many feet? \_\_\_\_\_

FROM	TO	LITHOLOGIC LOG	FROM	TO	LITHOLOGIC LOG
0	2	surface			
2	18	01 clay			
18	116	04 sandy clay			
116	130	07 fine sand			
130	191	04 sandy clay			
191	280	05 fine sand & medium to large sand			

7 CONTRACTOR'S OR LANDOWNER'S CERTIFICATION: This water well was (1) constructed, (2) reconstructed, or (3) plugged under my jurisdiction and was completed on (mo/day/year) November 11, 1983 and this record is true to the best of my knowledge and belief. Kansas Water Well Contractor's License No. 118 This Water Well Record was completed on (mo/day/yr) November 30, 1983 under the business name of Carlile Water Well Service, Inc. by (signature) Edward E. Means

INSTRUCTIONS: Use typewriter or ball point pen, PLEASE PRESS FIRMLY and PRINT clearly. Please fill in blanks, underline or circle the correct answers. Send top three copies to Kansas Department of Health and Environment, Division of Environment, Environmental Geology Section, Topeka, KS 66620. Send one to WATER WELL OWNER and retain one for your records.

D