


1 LOCATION OF WATER WELL: Fraction	Section Number	Township Number	Range Number
County: Seward NE 1/4 NE 1/4 SE 1/4	5	35	33W

Distance and direction from nearest town or city street address of well if located within city?
1002 N Kansas, Liberal, Kansas 67901

2 WATER WELL OWNER: **Mr. Don O'Kane Convenience Plus #2**
 RR#, St. Address, Box # **130 W Pancake Rd**
 City, State, ZIP Code : **Liberal, Ks 67901**
 Board of Agriculture, Division of Water Resources
 Application Number:

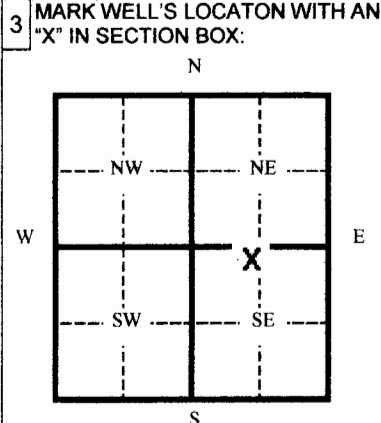

4 DEPTH OF WELL **81** ft.
 WELL'S STATIC WATER LEVEL **NA** ft.
 WELL WAS USED AS:
 1 Domestic 5 Public Water Supply 9 Dewatering
 2 Irrigation 6 Oil Field Water Supply 10 Monitoring Well
 3 Feedlot 7 Lawn and Garden (domestic) 11 Injection Well
 4 Industrial 8 Air Conditioning **12 Other Vapor Extraction**
 Was a chemical/bacteriological sample submitted to Department? Yes ___ No **x**
 If yes, mo/day/yr sample was submitted _____
 Water Well Disinfected: Yes ___ No **x**

5 TYPE OF BLANK CASING USED:
 1 Steel 3 RMP (SR) 5 Wrought 7 Fiberglass 9 Other (specify below)
2 PVC 4 ABC 6 Asbestos-Cement 8 Concrete Tile
 Blank casing diameter **4** in. Was casing pulled? Yes ___ No **x** If yes, how much _____
 Casing height above or below land surface **-36** in.

6 GROUT PLUG MATERIAL: 1 Neat cement 2 Cement grout **3 Bentonite** 4 Other _____
 Grout Plug Intervals From **3** ft **81** ft. From _____ ft. to _____ ft. From _____ ft. to _____ ft.
 What is the nearest source of possible contamination:
 1 Septic tank 6 Seepage pit 11 Fuel storage 16 Other (specify below)
 2 Sewer lines 7 Pit privy 12 Fertilizer storage **None**
 3 Watertight sewer lines 8 Sewage lagoon 13 Insecticide storage
 4 Lateral lines 9 Feedyard 14 Abandoned water well
 5 Cess Pool 10 Livestock pens 15 Oil well/ Gas well

Direction from well? _____ How many feet? _____

FROM	TO	CODE	PLUGGING MATERIALS
81	3		Bentonite
3	1		Native Material
1	0		Cement

7 CONTRACTOR'S OR LANDOWNER'S CERTIFICATION: This water well was plugged under my jurisdiction and was completed on (mo/day/yr) **5/18/08** and this record is true to the best of my knowledge and belief. Kansas
 This Water Well Record was completed on (mo/day/yr) **6/09/08** under the business name of **Wofter Pump & Well Inc.**
 by (signature) _____

INSTRUCTIONS: Please fill in blanks and circle the correct answers. Send three copies to Kansas Department of Health and Environment, Bureau of Water, 1000 S W Jackson St., Ste. 420, Topeka, Kansas 66620-0001. Telephone: 785-296-3565. Send one to Water Well Owner and retain one for your records.