

WATER WELL RECORD

Form WWC-5

Division of Water Resources App. No. _____


1 LOCATION OF WATER WELL:	Fraction	Section Number	Township Number	Range Number
County: Seward	N ¼ W ¼ NW ¼ NW ¼	4	T 35 S	R 33 <input type="checkbox"/> E <input checked="" type="checkbox"/> W

Street/Rural Address of Well Location; if unknown, distance & direction from nearest town or intersection: If at owner's address, check here .

3 East Railroad St., Liberal, Kansas

Global Positioning System (GPS) information:
 Latitude: _____ (in decimal degrees)
 Longitude: _____ (in decimal degrees)
 Elevation: _____
 Datum: WGS 84, NAD 83, NAD 27
 GPS unit (Make/Model: _____)
 Digital Map/Photo, Topographic Map, Land Survey
 Est. Accuracy: <3 m, 3-5 m, 5-15 m, >15 m

2 WATER WELL OWNER:KDHE T & M
 RR#, St. Address, Box # : 1000 SW Jackson
 City, State, ZIP Code : Topeka, Kansas

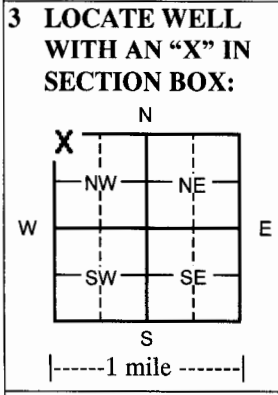

4 DEPTH OF COMPLETED WELL **180** ft.

Depth(s) Groundwater Encountered (1) _____ ft. (2) _____ ft. (3) _____ ft.

WELL'S STATIC WATER LEVEL **NA** ft. below land surface measured on mo/day/yr _____

Pump test data: Well water was _____ ft. after _____ hours pumping _____ gpm

EST. YIELD _____ gpm: Well water was _____ ft. after _____ hours pumping _____ gpm

WELL WATER TO BE USED AS: Public water supply Geothermal Injection well
 Domestic Feedlot Oil field water supply Dewatering Other (Specify below)
 Irrigation Industrial Domestic-lawn & garden **Monitoring well** **MW-3**

Was a chemical/bacteriological sample submitted to Department? Yes No
 If yes, mo/day/yr sample was submitted _____

Water Well Disinfected? Yes No

5 TYPE OF CASING USED: Steel PVC Other _____

CASING JOINTS: Glued Clamped Welded Threaded

Casing diameter **4** in. to **150** ft., Diameter _____ in. to _____ ft., Diameter _____ in. to _____ ft.

Casing height above land surface **0** in., Weight **2.07** lbs./ft. Wall thickness or gauge No. **.237**

TYPE OF SCREEN OR PERFORATION MATERIAL:
 Steel Stainless Steel PVC Other (Specify) _____
 Brass Galvanized Steel None used (open hole)

SCREEN OR PERFORATION OPENINGS ARE:
 Continuous Slot Mill slot Gauze wrapped Torch cut Drilled holes None (open hole)
 Louvered shutter Key punched Wire wrapped Saw cut Other (specify) _____

SCREEN-PERFORATED INTERVALS: From **150** ft. to **180** ft., From _____ ft. to _____ ft.
 From _____ ft. to _____ ft., From _____ ft. to _____ ft.

GRAVEL PACK INTERVALS: From **148** ft. to **180** ft., From _____ ft. to _____ ft.
 From _____ ft. to _____ ft., From _____ ft. to _____ ft.

6 GROUT MATERIAL: Neat cement Cement grout Bentonite Other _____

Grout Intervals From **0** ft. to **2** ft. From **2** ft. to **148** ft. From _____ ft. to _____ ft.

What is the nearest source of possible contamination:
 Septic tank Lateral lines Pit privy Livestock pens Insecticide storage Other (specify below)
 Sewer lines Cesspool Sewage lagoon Fuel storage Abandoned water well
 Watertight sewer lines Seepage pit Feedyard Fertilizer storage Oil well/gas well **Contaminated site**

Direction from well _____ Distance from well _____

FROM	TO	LITHOLOGIC LOG	FROM	TO	LITHO. LOG (cont.) or PLUGGING INTERVALS
0	2	Surface	165	180	Clay & caliche w/fine sand strks
2	13	Sandy Clay w/clay strks			
13	18	Clay & caliche w/sandy clay strks			
18	23	Clay & sandy clay w/caliche strks			
23	44	Clay w/caliche strks			
44	65	Sandy clay w/clay & caliche strks			
65	86	Clay & caliche w/sandy clay lenses			
86	105	Sandy clay w/clay & caliche			
105	153	Clay & caliche w/sandy clay lenses			
153	165	Clay & caliche w/sandy clay strks			

7 CONTRACTOR'S OR LANDOWNER'S CERTIFICATION: This water well was constructed, reconstructed, or plugged under my jurisdiction and was completed on (mo/day/year) **5/26/10** and this record is true to the best of my knowledge and belief. Kansas Water Well Contractor's License No. **(554) or 783**. This Water Well Record was completed on (mo/day/year) **6/15/10** under the business name of **Woofter Pump & Well, Inc** by (signature) *Jay L. Woofter*

INSTRUCTIONS: Please fill in blanks and check the correct answers. Send three copies (white, blue, pink) to Kansas Department of Health and Environment, Bureau of Water, Geology Section, 1000 SW Jackson St., Suite 420, Topeka, Kansas 66612-1367. Telephone 785-296-5522. Send one to WATER WELL OWNER and retain one for your records. Include fee of \$5.00 for each constructed well. Visit us at <http://www.kdheks.gov/waterwell/index.html>.