

WATER WELL RECORD

Form WWC-5


Division of Water Resources App. No.

1 LOCATION OF WATER WELL: County: Seward	Fraction SE 1/4 SW 1/4 SE 1/4 1/4	Section Number 6	Township No. T 35 S	Range Number R 33 <input type="checkbox"/> E <input checked="" type="checkbox"/> W
-----------------------------------------------------------	---------------------------------------------	----------------------------	-------------------------------	----------------------------------------------------------------------------------------------

Street/Rural Address of Well Location; if unknown, distance & direction from nearest town or intersection: If at owner's address, check here .
0.4 Miles SW of West 2nd Street Road and Western Avenue.

Global Positioning System (GPS) information:
 Latitude: **37.01.621'** (in decimal degrees)
 Longitude: **100.56.718'** (in decimal degrees)
 Elevation: **2856.22' MSL**
 Datum: WGS 84, NAD 83, NAD 27
 Collection Method:
 GPS unit (Make/Model: **Garmin / Etrex**)
 Digital Map/Photo, Topographic Map, Land Survey
 Est. Accuracy: <3 m, 3-5 m, 5-15 m, >15 m

2 WATER WELL OWNER: **TRC**
 RR#, Street Address, Box #: **10011 Meadowalen Lane. Suite 100**
 City, State, ZIP Code : **Houston, Texas 77042**

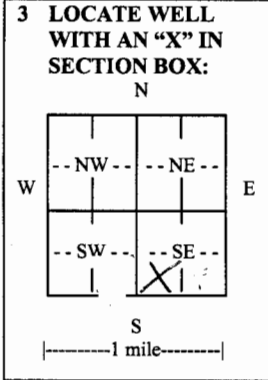

4 DEPTH OF COMPLETED WELL **205** ft.

Depth(s) Groundwater Encountered (1) **186** ft. (2)..... ft. (3)..... ft.

WELL'S STATIC WATER LEVEL.....ft. below land surface measured on mo/day/yr.....

Pump test data: Well water was.....ft. after..... hours pumping..... gpm

EST. YIELD.....gpm. Well water was.....ft. after..... hours pumping..... gpm

Bore Hole Diameterin. toft., andin. toft.

WELL WATER TO BE USED AS: Public water supply Geothermal Injection well
 Domestic Feedlot Oil field water supply Dewatering Other (Specify below)
 Irrigation Industrial Domestic-lawn & garden Monitoring well **YELLOW-16**

Was a chemical/bacteriological sample submitted to Department? Yes No

If yes, mo/day/yr sample was submitted.....

Water well disinfected? Yes No

5 TYPE OF CASING USED: Steel PVC Other.....

CASING JOINTS: Glued Clamped Welded Threaded

Casing diameter **.4** in. to **.175** ft., Diameter in. to ft., Diameter in. to ft.

Casing height above land surface **3'** in., Weightlbs./ft., Wall thickness or gauge No. **SCH. 40**

TYPE OF SCREEN OR PERFORATION MATERIAL:
 Steel Stainless Steel PVC Other (Specify).....
 Brass Galvanized Steel None used (open hole)

SCREEN OR PERFORATION OPENINGS ARE:
 Continuous slot Mill slot Gauze wrapped Torch cut Drilled holes None (open hole)
 Louvered shutter Key punched Wire wrapped Saw cut Other (specify).....

SCREEN-PERFORATED INTERVALS: From **.175** ft. to **.205** ft., From ft. to ft.
 From ft. to ft., From ft. to ft.

GRAVEL PACK INTERVALS: From **.173** ft. to **.205** ft., From ft. to ft.
 From ft. to ft., From ft. to ft.

6 GROUT MATERIAL: Neat cement Cement grout Bentonite Other.....

Grout Intervals: From **0** ft. to **157** ft., From **157** ft. to **173** ft., From ft. to ft.

What is the nearest source of possible contamination:
 Septic tank Lateral lines Pit privy Livestock pens Insecticide storage Other (specify below)
 Sewer lines Cesspool Sewage lagoon Fuel storage Abandoned water well
 Watertight sewer lines Seepage pit Feedyard Fertilizer storage Oil well/gas well.....

Direction from well Distance from well

FROM	TO	LITHOLOGIC LOG	FROM	TO	LITHO. LOG (cont.) or PLUGGING INTERVALS
0'	95'	Silty Sand, Grayish w/ Brown			
95'	176'	Clayey Silt, Dark Grayish Brown			
176'	186'	Silty Sand, Brown, Moist			
186'	197'	Unconsolidated Sand, Brown, Wet			
197'	205'	Sand, Grayish Brown, Very Wet			

Original Returned to Sender
for Correction Date: 8/30/10

7 CONTRACTOR'S OR LANDOWNER'S CERTIFICATION: This water well was constructed, reconstructed, or plugged under my jurisdiction and was completed on (mo/day/year) **4/8/2010**..... and this record is true to the best of my knowledge and belief.

Kansas Water Well Contractor's License No. **597**..... This Water Well Record was completed on (mo/day/year) **8/12/2010**..... under the business name of **Boart Longyear Company**..... by (signature) *[Signature]*

INSTRUCTIONS: Use typewriter or ball point pen. **PLEASE PRESS FIRMLY** and **PRINT** clearly. Please fill in blanks and check the correct answers. Send three copies (white, blue, pink) to Kansas Department of Health and Environment, Bureau of Water, Geology Section, 1000 SW Jackson St., Suite 420, Topeka, Kansas 66612-1367. Telephone 785-296-5522. Send one copy to WATER WELL OWNER and retain one for your records. Include fee of \$5.00 for each constructed well. Visit us at <http://www.kdheks.gov/waterwell/index.html>.

26 MAINTENANCE FACILITY YELLOW 16 INSTALLATION

Book No. _____

Liberal, KS Seward County
 Water at 182'
 INSTALLATION AT YELLOW - 16

<u>IAL</u>	<u>RECOVERY</u>	<u>PIO</u>	<u>DESCRIPTION</u>
3-5	2-2	-	CLEARED WITH POST HOLE DIGGER, LOAM SOIL/FILL Begin drilling, sandy silt, brown, moist
5-7	2-2	-	SAME AS ABOVE (SAA), INTERMITTENT SILT LIKE LIKE CaCO ₃ nodules nodules
7-14	7-7	-	SAA, Caliche content increasing SAA, silt with ~10% sand and 40% clay lenses of CaCO ₃ throughout interval
#		-	silty clay sand, light brown, ~10% clay no CaCO ₃ , clay content increasing downward, no CaCO₃ dry
14-16 #	7-7	-	silty clay sand, decreasing amounts of clay & silt, light brown color, intermittent CaCO ₃ layers, dry
16-18		1.3	1.3 ppm SAA, increased clay & silt content up to ~20% clean fine sand in 16½-17 interval
21			sandy silt, ~20% sand, grayish brown decreasing downward to light grayish brown; at 19' presence of CaCO ₃ increasing downward, some moisture
21-24	7-7		Very light grayish brown sand decreasing down to light brown sand w/ some silt ± (less than 10%)
24-28			silty sand, brown, dry with increasing color downward, dry

To Page No. _____

d & Understood by me,

Date

Invented by

Date

April 6, 2016

Project No. 1053151

Book No. _____

TITLE Liberal Maintenance Facility Yellow 16 Installation

11

15

Page No. _____

Continued from pg. 75

Time	Interval	Recovery	PID	Description
1:40	28-32	4- 7	0	Very fine sand, clean sand, light grayish brown transitioning to light brown, dry, increasing color and moisture downward
	35-37 35-37	6-7	0	silt w/ trace of sand, brown color transitioning to light gray, dry transitioning to wet, at 33 1/2' very fine grayish brown sand, moist
	37-41 34-38		0	Very fine sand, moist light grayish brown transitioning to brown, trace silt at bottom of interval, moisture decreasing down to dry
	42-44 38-40	7-7	0	sandy silt, grayish brown transitioning to very light grayish brown, dry, 20% sand
	44-46			SAA, light brown darkening downward, trace sand at bottom.
	46-48			clayey silt w/ trace sand, brown, some moisture, trace CaCO ₃ nodules
10	49 48 56	7-7	0	SAA
00	56-57			SAA
	57-58			SILTY SANDY, LIGHT BROWN, VERY FINE SAND, MOIST
	58 (P)			
	58-62			SANDY SILT, LIGHT BROWN TRANSITIONING TO GRAYISH BROWN THROUGHOUT INTERVAL, INTERMIXED CaCO ₃ NODULES, DRY

Continued on 77 →

To Page No. _____

Witnessed & Understood by me, _____

Date _____

Invented by _____

Date _____

Page No. _____

CONTINUED FROM 76

<u>ME</u>	<u>INTERVAL</u>	<u>RECOVERY</u>	<u>PID</u>	<u>DESCRIPTION</u>
NT.	62-64		0	FINE SAND, LIGHT GRAYISH BROWN, CLEAN SAND, DRY
0	64-71	7-7	0	SANDY SILT, BROWN, INTERMITTENT CaCO ₃ , DRY
12	71-78 73-75 77-78	7-7	0	SAA @ 73-75 CEMENTED SANDS, HEAVY CaCO ₃ SANDY SILT APPROXIMATELY 40% SAND, WHITISH GRAY, DRY @ 77-78, FINE SAND, LIGHT GRAYISH, BROWN, CLEAN, MOIST
34	78-85	6-7	0	SILTY SAND, BROWN, INTERMITTENT CaCO ₃ NODULES, MOISTURE INCREASING DOWN NO INDICATION OF WATER / SATURATION
50	85-92	5-7	0	FINE SAND, BROWN TRANSITIONING TO LIGHT GRAYISH BROWN AT 86', CLEAN MOIST w/ MOISTURE INCREASING TO DAMP, LIKELY TOP OF WATER, NO INDICATION OF IMPACTS
00	92- 96 ⁹⁵	7-7		clean fine sand, grayish brown, moist, layer of silt 93 1/2', to ^{to} sand transition to unconsolidated mixed sand increasing downward w/ trace gravel up to 1/2" dia at bottom of interval

stepped BS

17, 2010

Continue on 78

To Page No.

3 April 7, 2010

Project No. 105759

Book No. _____

TITLE Liberal Maintenance Facility Yellow 16 Install

on Page No. _____

continued from page 77

<u>Time</u>	<u>Interval</u>	<u>Recovery</u>	<u>PI D</u>	<u>Description</u>
	95-99			clayey silt, dark brown, dense, moderate plasticity, damp, near water interval, bottom + @ 90' uncemented sand, brown mixed between fine and coarse s. w/ trace gravel, damp, maybe a water-bearing area w/ very low yield.
	99-106	7-7		@ 99' to 99.5' fine ^{to medium} sand, grayish brown, damp @ 99.5' clayey silt, grayish brown up to 40% clay decreasing downward, inter CACO ₃ increasing downward up to 50%, moisture decreasing downward, high places at 99.5 to 100.5 decreasing downward crumbly
				@ 102 ^{99.5} 102' clayey silt to silty clay, grayish brown, trace sand, trace CACO ₃ nodules, ve good plasticity, damp to wet
				@ 105' sandy silt w/ up to 20% sand, whitish gray transitioning to white, some cementation at 105.5', somewhat damp dry, low plasticity to near ^{is} crumbly
	106-113	7-7		SAA, decreasing sand, moisture content inc somewhat, poor to crumbly plasticity @ 108' SAA, poor plasticity, transitioning from white to white grayish brown and somewhat pinkish @ 109' SAA, moisture increasing downward @ 111' SAA, light grayish brown, med sand content up to 20%, some plasticity moisture increasing

continue on pg 79

To Page No. _____

Witnessed & Understood by me.

Date

Invented by

Date

Page No. _____

Continued from pg 78

<u>Depth</u>	<u>Interval</u>	<u>Recovery</u>	<u>PII</u>	<u>Description</u>
	113-120	7-7		clayey silt, trace sand, intermittent CaCO ₃ , light grayish brown transitioning to dark brown, color indicative to % of CaCO ₃ within silt lenses, some moisture @ 116 ^{BS} some plasticity @ 116' SAA increasing amounts of CaCO ₃ , poor plasticity and crumbly, decreasing amounts of moisture to dry, color transition from light grayish brown to white @ 118' SAA, no moisture, dry, crumbly
00	120-130	7-10		clayey silt, trace CaCO ₃ , dark grayish brown, poor to crumbly plasticity, very little moisture @ 122' SAA, varying percentages of CaCO ₃ up to 20%, some plasticity, some moisture @ 126' silt, trace sand and clay, poor plasticity, light brown, some moisture
20	130-131	7-7		SAA ^{BS} clayey sandy silt, light brown, low plasticity, up to 30% clay, up to 20% sand, some moisture @ 132 SAA ^{BS} clayey silt, trace sand, light gray, strong presence of CaCO ₃ up to 50 which causes distinctive color change to ^{BS} , some moisture, decreasing clay content downward, crumbly @ 135 SAA, color changing to pink

Continue on pg 79

To Page No. _____

Inspected & Understood by me,

Date

Invented by

Date

from Page No. _____

Continued from pg 74

Time	Interval	Recovery	PLU	Description
	137- 146 ^{BS} 147	8-9 ^{BS} 9-10		clayey silt, trace sand, very light grayish brown transitioning to very light gray, poor plasticity to crumbly, little moisture @ 139' ^{BS} white SAA, white, crumbly, ^{BS} moj up to 60% CaCO ₃ @ 142' SAA
	147- 154 ^{BS} 157	9-10		SAA, white, CaCO ₃ up to 60%, ^{trace} cementation, nodules @ 153' SAA, moisture content decreasing downward, appears to be dry at bottom of unit
1530	157- 168 ^{BS}	7-8 ^{BS} 9		SAA, pinkish, to very light brown @ 160' light brown SAA, light brown, somewhat moist with decreasing moisture downward

April 8, 2010

0730 ~~168~~^{BS} 176 9-10
 clayey silt, trace sand, grayish brown, some cementation, ^{BS} up to 20% ^{trace} gravel
 no larger than 3/4", poor plasticity, moist
 @ 174' SAA, light gray, crumbly, little moisture

0830 176-186 6-10
 clayey silty sand, brown w/ iron staining, cementation throughout interval caused by CaCO₃ up to 20% clay and silt, wet, top of water unit.

continue on pg 86

To Page No _____

Page No. _____

Minuted from page 80

e Interval Recovery PID Description

@ 179' SAA, gray, cementation caused by CaCO₃, up to 6%. CaCO₃, somewhat ^{BS} cement chunks up to 2" thick, somewhat moist

@ 183' sandy silt, light gray, large amount of cementation due to heavy CaCO₃ content; sand ranging from fine to coarse grain, dry

182-187

silty sand, ~~is~~ brown, fine to medium grain sand, CaCO₃ nodules, wet

@ 185' clayey silt, dark gray, small amount of CaCO₃ nodules, high plasticity, wet

@ 186' unconsolidated sand, alternating 4" intervals of fine to medium sand, ~~coarse~~ ^{BS} and coarse sand, 4" intervals of dark gray and light brown, wet throughout

187-197

Sand, unconsolidated fine and medium grains of sand, brown, wet

@ 190' silty clay, gray brown, iron staining, trace sand found in silt lenses, wet; clay is very dense and highly plastic

@ 192' silty sand with silt decreasing downward, iron staining, very moist

197-205

^{BS} silty sand, grayish brown, unconsolidated fine to medium grain sand, very wet

GROUT: Portland cement w/ ^{~17-21%} ~~5%~~ ^{BS} Bentonite powder
 BENTONITE: 3/8 hole plug to ~~5' above sand (168' depth)~~ ^{BS} ~~6.6'~~ ^{15.6'} above sand (~~166'~~ ^{157'} d)
 SAND: 10/20 to 2 1/2" above screen (~~173' depth~~) ^{BS} (172.6' depth)
 WELL CASING: 4" Sch. 40 w/ centralizer approximately every 50'
 WELL SCREEN: #20 slotted 50 ft
 BOREHOLE SIZE: 9"


To Page No



BORING/MONITOR WELL DIAGRAM

WELL No. Yellow-16

PROJECT: Liberal Maintenance Facility and CS	DATE STARTED: 06 April 2010	GROUND ELEVATION: 2856.22' MSL
FIELD GEOLOGIST: B. Salas	DATE FINISHED: 08 April 2010	NORTHING: 1452907.34
DESIGNED BY: A. Lusk	BORING DEPTH: 205' BGS	EASTING: 598351.13
DRILLING COMPANY: Boart Longyear	BOREHOLE DIAMETER: 8" & 9"	DATE SAMPLED: 26 April 2010
DRILLING METHOD: Sonic	WELL DIAMETER: 4" PVC	LOCATION: East of DCP Fenceline in CRP
SAMPLING METHOD: Continuous core	TOP OF CASING ELEVATION: 2859.11' MSL	

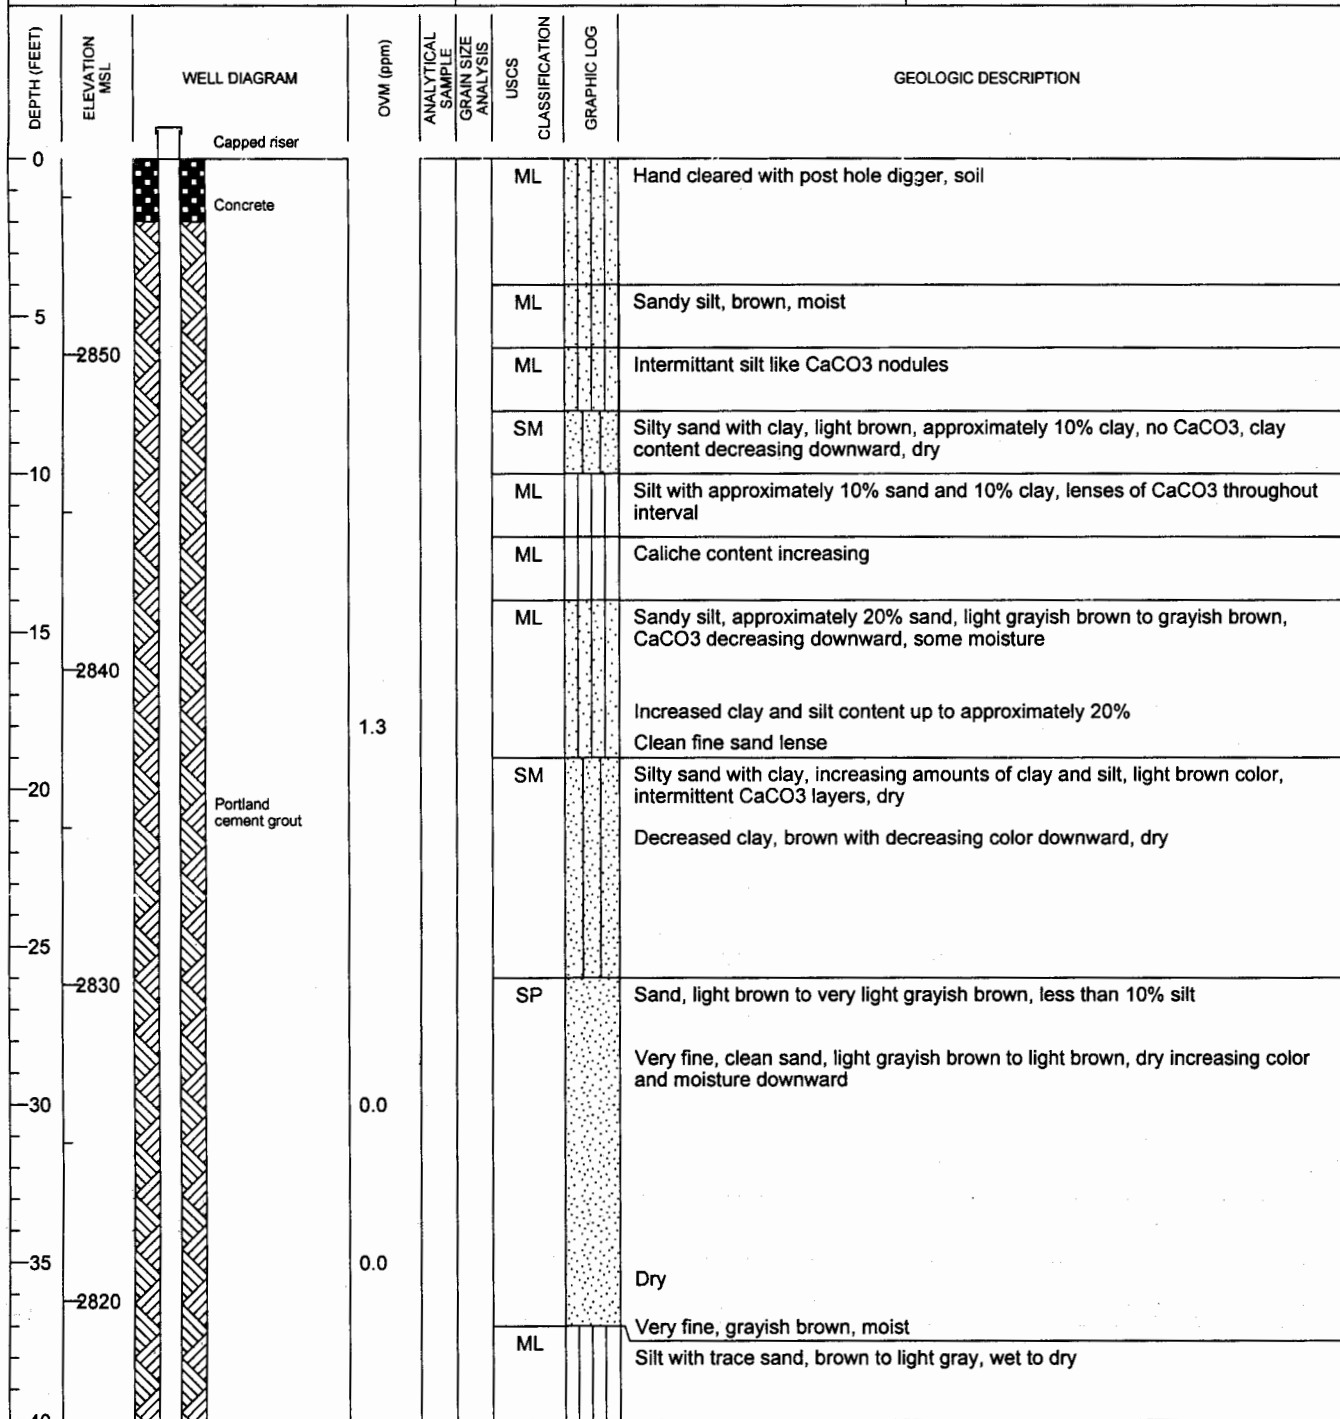


Total Depth of Boring: 205 ft
 These logs should not be used separately from the original report.



BORING/MONITOR WELL DIAGRAM

WELL No. Yellow-16

PROJECT: Liberal Maintenance Facility and CS	DATE STARTED: 06 April 2010	GROUND ELEVATION: 2856.22' MSL
FIELD GEOLOGIST: B. Salas	DATE FINISHED: 08 April 2010	NORTHING: 1452907.34
DESIGNED BY: A. Lusk	BORING DEPTH: 205' BGS	EASTING: 598351.13
DRILLING COMPANY: Boart Longyear	BOREHOLE DIAMETER: 8" & 9"	DATE SAMPLED: 26 April 2010
DRILLING METHOD: Sonic	WELL DIAMETER: 4" PVC	LOCATION: East of DCP Fenceline in CRP
SAMPLING METHOD: Continuous core	TOP OF CASING ELEVATION: 2859.11' MSL	

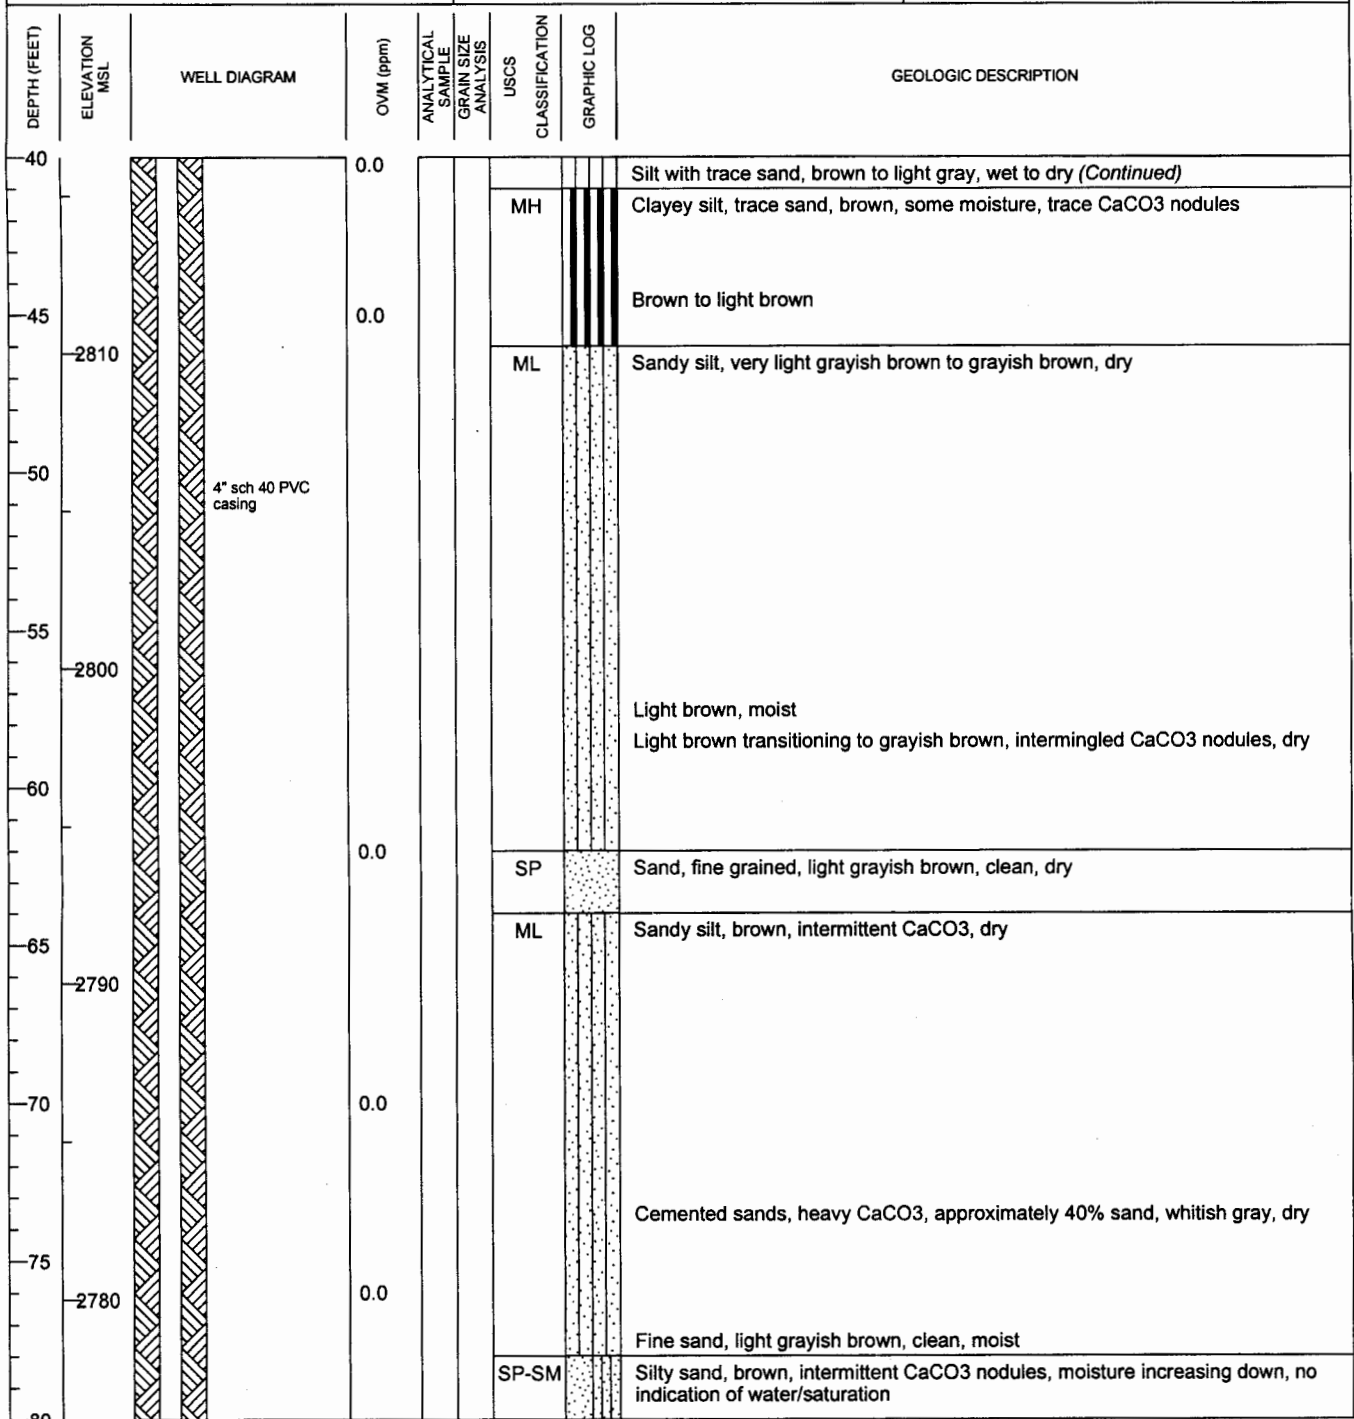


Total Depth of Boring: 205 ft
 These logs should not be used separately from the original report.



BORING/MONITOR WELL DIAGRAM

WELL No. Yellow-16

PROJECT: Liberal Maintenance Facility and CS	DATE STARTED: 06 April 2010	GROUND ELEVATION: 2856.22' MSL
FIELD GEOLOGIST: B. Salas	DATE FINISHED: 08 April 2010	NORTHING: 1452907.34
DESIGNED BY: A. Lusk	BORING DEPTH: 205' BGS	EASTING: 598351.13
DRILLING COMPANY: Boart Longyear	BOREHOLE DIAMETER: 8" & 9"	DATE SAMPLED: 26 April 2010
DRILLING METHOD: Sonic	WELL DIAMETER: 4" PVC	LOCATION: East of DCP Fenceline in CRP
SAMPLING METHOD: Continuous core	TOP OF CASING ELEVATION: 2859.11' MSL	

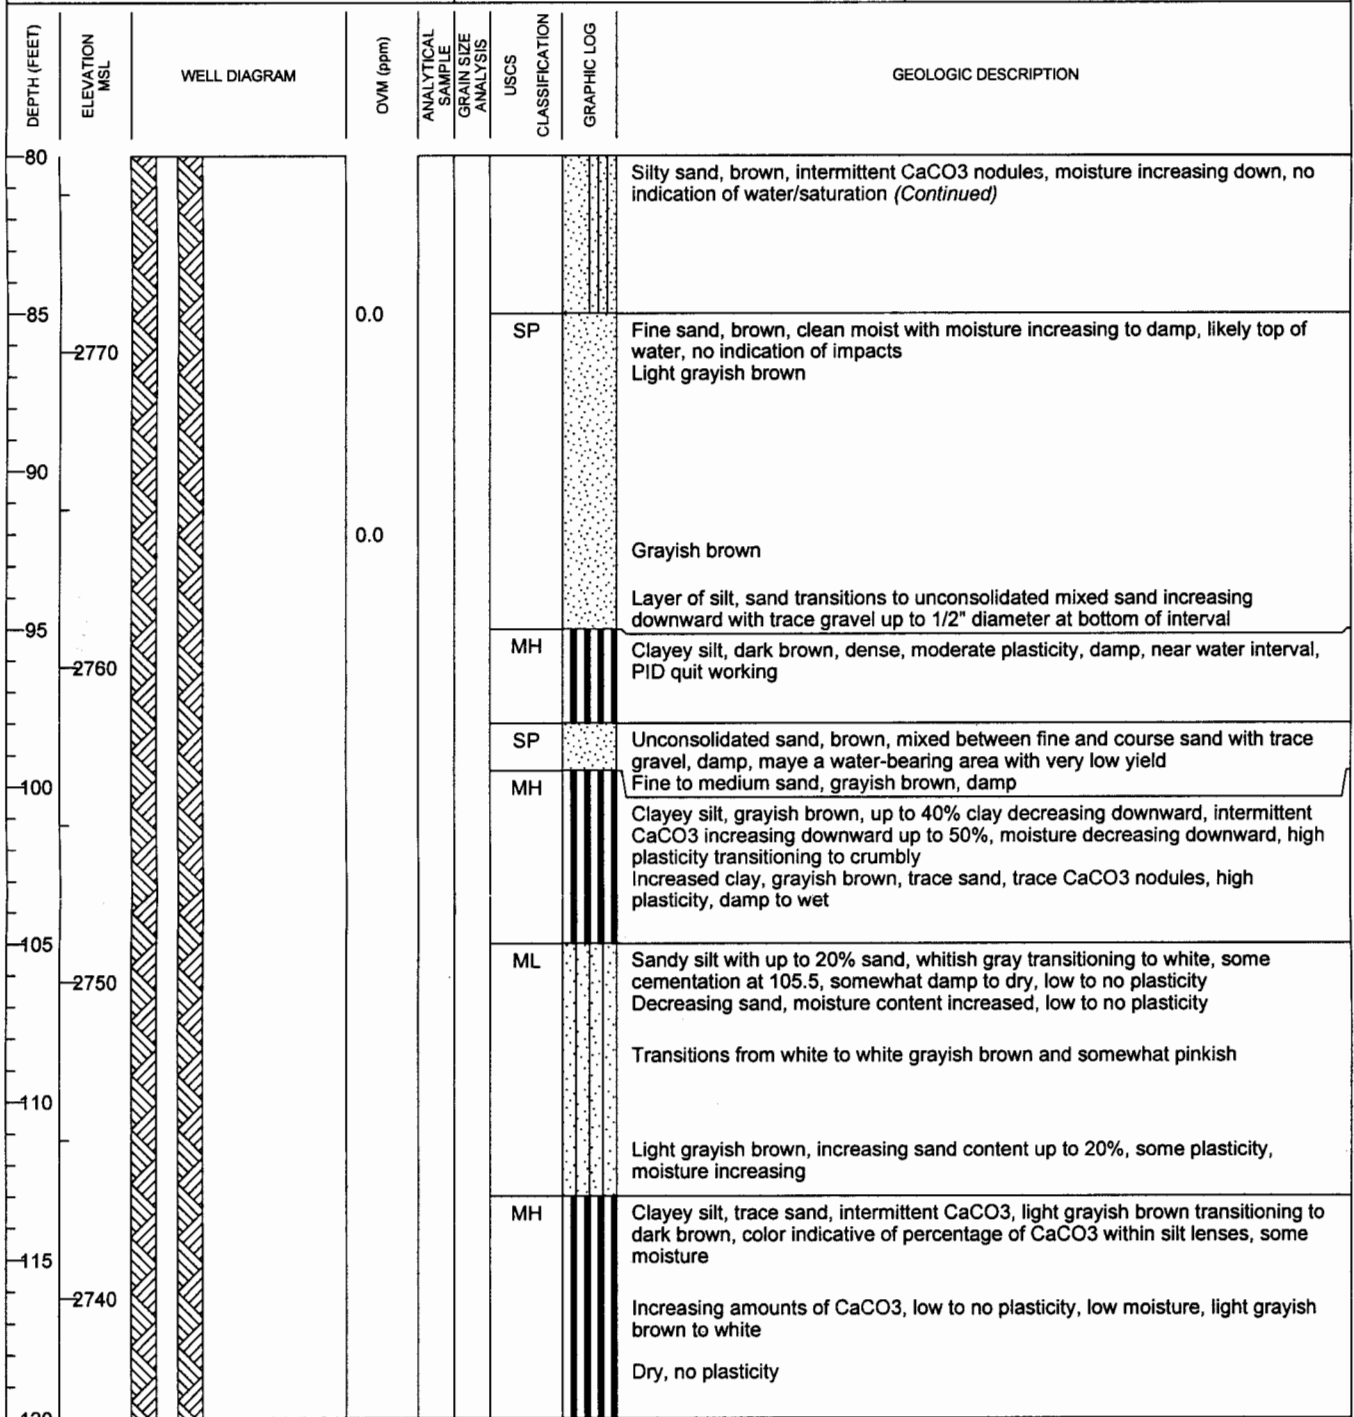

Total Depth of Boring: 205 ft


These logs should not be used separately from the original report.



BORING/MONITOR WELL DIAGRAM

WELL No. Yellow-16

PROJECT: Liberal Maintenance Facility and CS	DATE STARTED: 06 April 2010	GROUND ELEVATION: 2856.22' MSL
FIELD GEOLOGIST: B. Salas	DATE FINISHED: 08 April 2010	NORTHING: 1452907.34
DESIGNED BY: A. Lusk	BORING DEPTH: 205' BGS	EASTING: 598351.13
DRILLING COMPANY: Boart Longyear	BOREHOLE DIAMETER: 8" & 9"	DATE SAMPLED: 26 April 2010
DRILLING METHOD: Sonic	WELL DIAMETER: 4" PVC	LOCATION: East of DCP Fenceline in CRP
SAMPLING METHOD: Continuous core	TOP OF CASING ELEVATION: 2859.11' MSL	

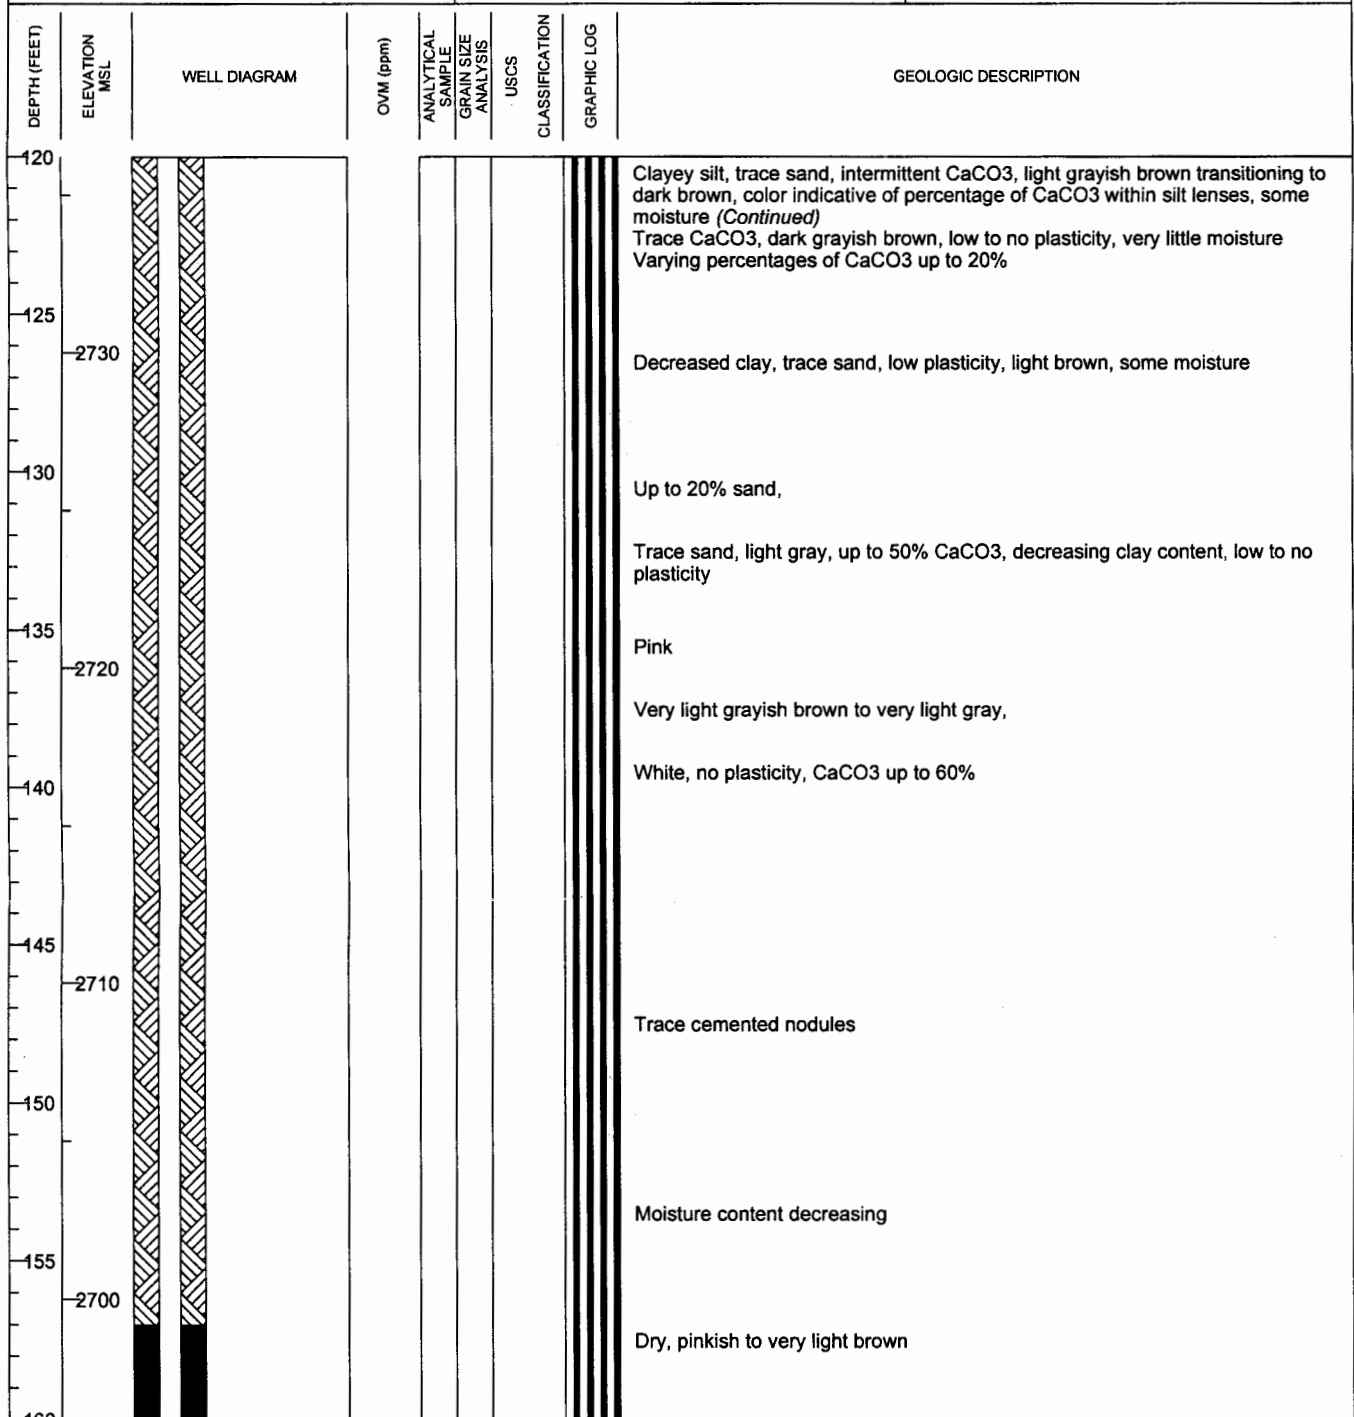


Total Depth of Boring: 205 ft
 These logs should not be used separately from the original report.



BORING/MONITOR WELL DIAGRAM

WELL No. Yellow-16

PROJECT: Liberal Maintenance Facility and CS	DATE STARTED: 06 April 2010	GROUND ELEVATION: 2856.22' MSL
FIELD GEOLOGIST: B. Salas	DATE FINISHED: 08 April 2010	NORTHING: 1452907.34
DESIGNED BY: A. Lusk	BORING DEPTH: 205' BGS	EASTING: 598351.13
DRILLING COMPANY: Boart Longyear	BOREHOLE DIAMETER: 8" & 9"	DATE SAMPLED: 26 April 2010
DRILLING METHOD: Sonic	WELL DIAMETER: 4" PVC	LOCATION: East of DCP Fenceline in CRP
SAMPLING METHOD: Continuous core	TOP OF CASING ELEVATION: 2859.11' MSL	

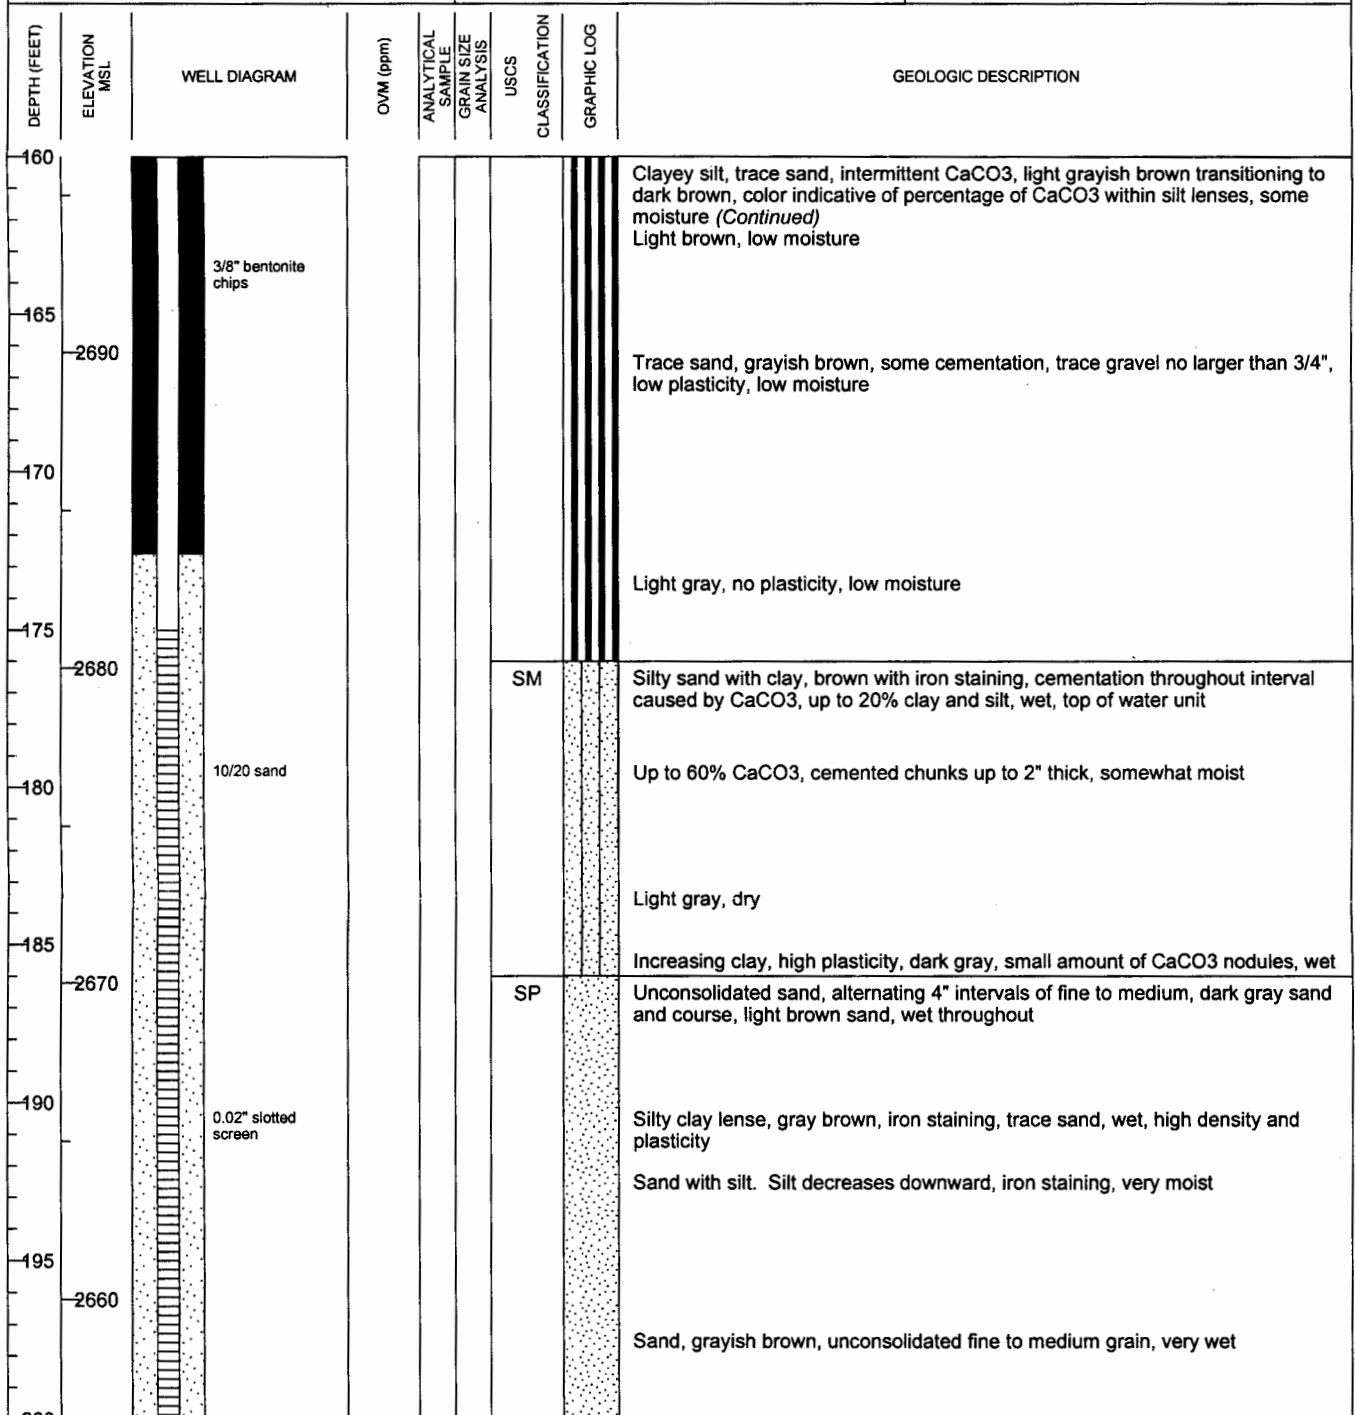


Total Depth of Boring: 205 ft
 These logs should not be used separately from the original report.



BORING/MONITOR WELL DIAGRAM

WELL No. Yellow-16

PROJECT: Liberal Maintenance Facility and CS	DATE STARTED: 06 April 2010	GROUND ELEVATION: 2856.22' MSL
FIELD GEOLOGIST: B. Salas	DATE FINISHED: 08 April 2010	NORTHING: 1452907.34
DESIGNED BY: A. Lusk	BORING DEPTH: 205' BGS	EASTING: 598351.13
DRILLING COMPANY: Boart Longyear	BOREHOLE DIAMETER: 8" & 9"	DATE SAMPLED: 26 April 2010
DRILLING METHOD: Sonic	WELL DIAMETER: 4" PVC	LOCATION: East of DCP Fenceline in CRP
SAMPLING METHOD: Continuous core	TOP OF CASING ELEVATION: 2859.11' MSL	

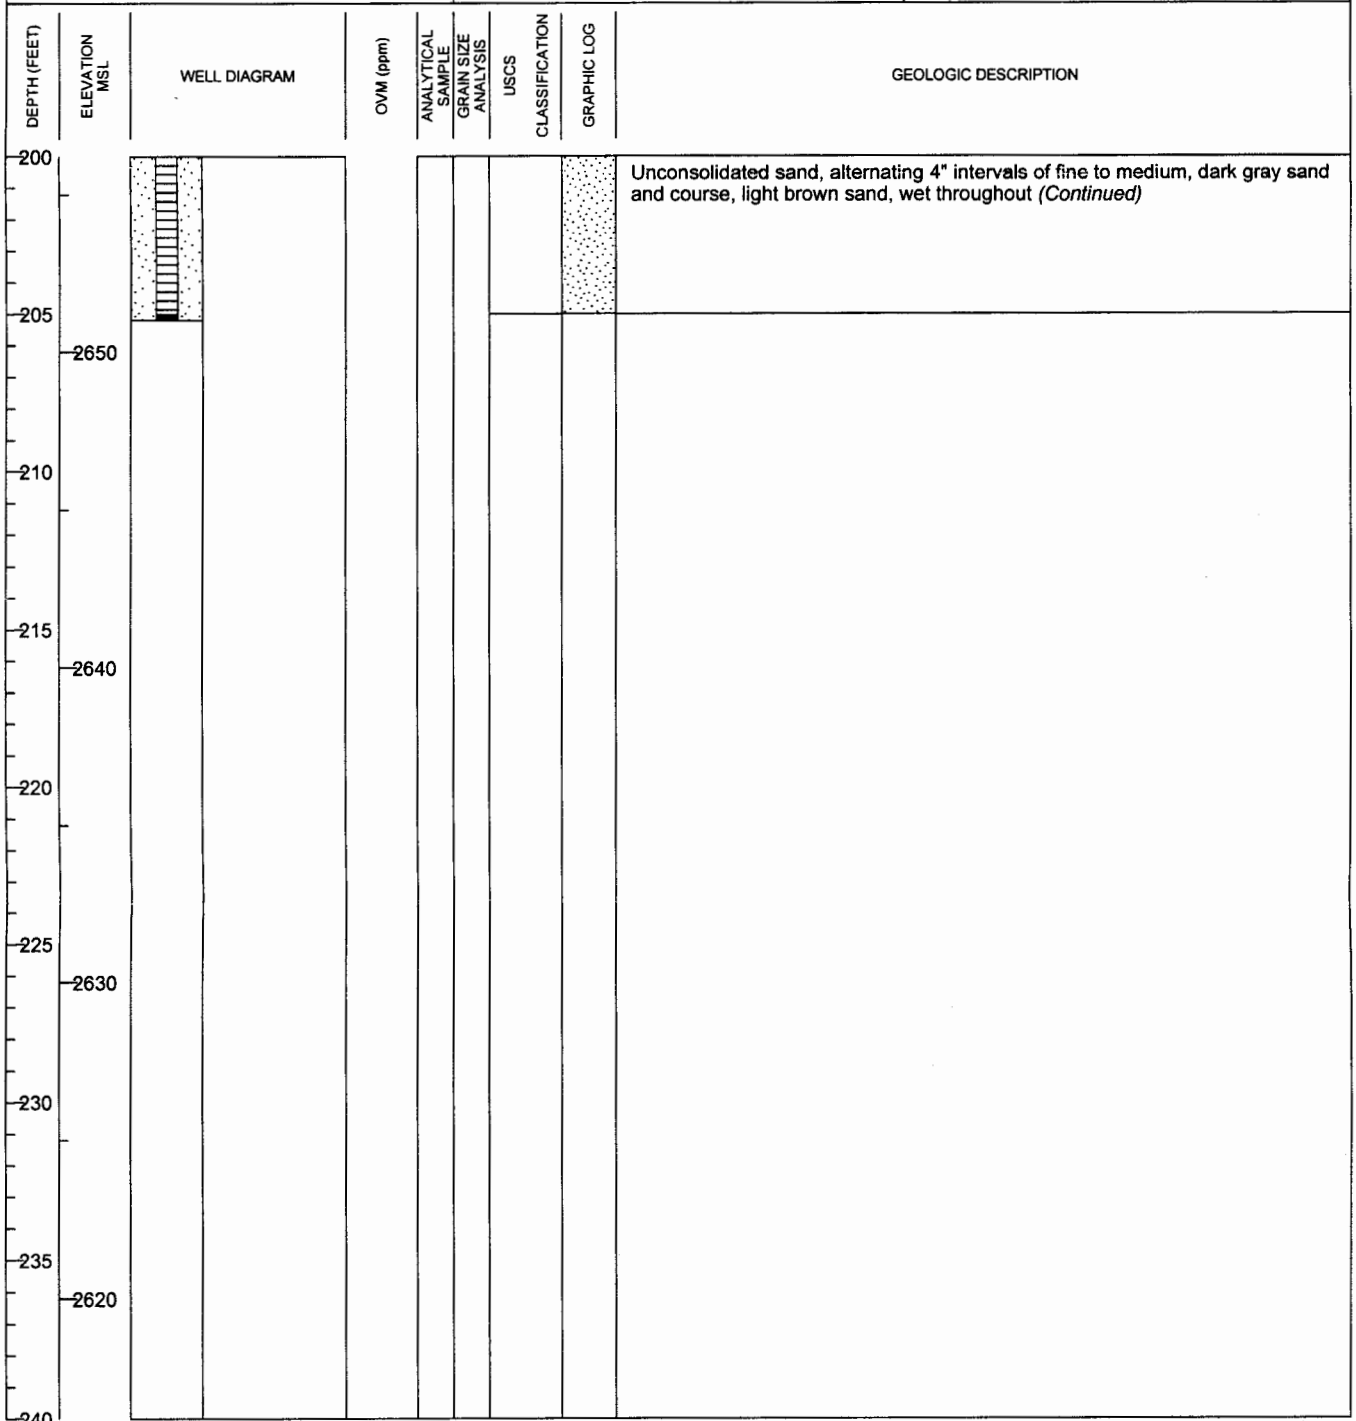

Total Depth of Boring: 205 ft
 These logs should not be used separately from
 the original report.