WATER WELL PLUGGING RECORD Form WWC-5P KSA 82a-1212 ID NO.

1 LOCATION OF WATER WELL: County: Seward	Fraction NW ¼ NW ¼ NW ¼	Section Number 9	Township Number 35	Range Number 33 (W)

Distance and direction from nearest town or city street address of well if located within city?

905 South Kansas Avenue Liberal, Kansas

2 WATER WELL OWNER:
Madden Oil Co.
c/o James Madden
32684 Upper Bear Creek Road
Evergreen, CO 80439

Global Positioning Systems (decimal degrees, min. of 4 digits
Latitude: _____
Longitude: _____
Elevation: _____
Datum: _____
Data Collection Method:

3 MARK WELL'S LOCATION WITH AN "X" IN SECTION BOX:

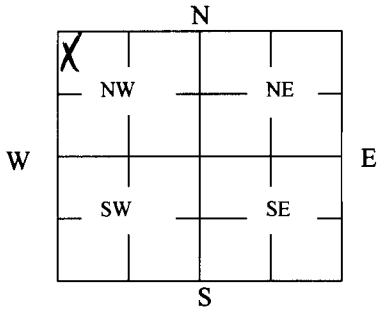

4 DEPTH OF WELL _____**49.31**_____ **ft.**

WELL'S STATIC WATER LEVEL_____**Dry**_____ft

WELL WAS USED AS:

1 Domestic
2 Irrigation
3 Feedlot
4 Industrial
5 Public Water Supply
6 Oil Field Water Supply
7 Domestic (Lawn & Garden)
8 Air Conditioning
9 Dewatering
10 Monitoring
11 Injection Well
12 Other _Extraction Well_

Was a chemical/bacteriological sample submitted to Department? Yes_____ No __X__

5 TYPE OF BLANK CASING USED:
1 Steel
2 PVC
3 RMP (SR)
4 ABS
5 Wrought
6 Asbestos-Cement
7 Fiberglass
8 Concrete Tile
9 Other (Specify below) _____

Blank casing diameter __**4**__ in. Was casing pulled? Yes __**X**__ No _____ If yes, how much ___**3 Feet**_____
Casing height above or below land surface _____ in.

6 GROUT PLUG MATERIAL: 1 Neat cement 2 Cement grout **3 Bentonite** 4 Other _____

Grout Plug Intervals: From __**3**__ ft. to __**49**__ ft., From _____ ft. to _____ft., From _____ to _____ ft.

What is the nearest source of possible contamination:
1 Septic tank
2 Sewer lines
3 Watertight sewer lines
4 Lateral lines
5 Cess pool
6 Seepage pit
7 Pit privy
8 Sewage lagoon
9 Feedyard
10 Livestock pens
11 Fuel Storage
12 Fertilizer storage
13 Insecticide storage
14 Abandoned water well
15 Oil well/Gas well
16 Other (specify below)
_Lust Site_____

Direction from well? _____
How many feet? _____

FROM	TO	PLUGGING MATERIALS	FROM	TO	PLUGGING MATERIALS
0	**1**	**Concrete**			
1	**3**	**Native soils**			
3	**49**	**Bentonite solids**			
					SVS

7 CONTRACTOR'S OR LANDOWNER'S CERTIFICATION: This water well was plugged under my jurisdiction and was completed on (mo/day/year) **_06/01/2011**_____ and this record is true to the best of my knowledge and belief. Kansas Water Well Contractor's License No. __**594**___. This Water Well Record was completed on (mo/day/year) 06/22/2011_____ under the business name of **Coranco Great Plains, Inc.** by (signature) _____.

INSTRUCTIONS: Use typewriter or ballpoint pen. Please press firmly and print clearly. Please fill in blanks, underline or circle the correct answers. Send top three copies to Kansas Department of Health and Environment, Bureau of Water, Geology Section, 1000 SW Jackson St., Ste. 420, Topeka, Kansas 66612-1367. Telephone: 785/296-5522. Send one to Water Well Owner and retain one for your records. Visit us at http://www.kdheks.gov/waterwell/index.html.