


1	LOCATION OF WATER WELL:	Fraction	Section Number	Township Number	Range Number
	County: Seward	NW 1/4 NW 1/4 NW 1/4	4	35	33W EW

Distance and direction from nearest town or city street address of well if located within city?
 3 East Railroad Street, Liberal, Kansas

2 WATER WELL OWNER: Kansas Department of Health & Env
 RR #, St. Address, Box #: 1000 SW Jackson, Suite 410
 City, State, ZIP Code: Topeka, KS 666
 Board of Agriculture, Division of Water Resources
 Application Number:

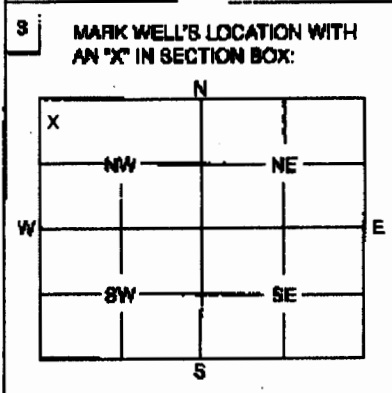

4 DEPTH OF WELL 181 ft.
 WELL'S STATIC WATER LEVEL 160 ft.
 WELL WAS USED AS:
 1 Domestic 5 Public Water Supply 9 Dewatering
 2 Irrigation 6 Oil Field Water Supply 10 Monitoring Well
 3 Feedlot 7 Domestic (Lawn & Garden) 11 Injection Well
 4 Industrial 8 Air Conditioning 12 Other
 Was a chemical / bacteriological sample submitted to Department? Yes No
 If yes, mo/day/yr sample was submitted
 Water Well Disinfected: Yes No

5 TYPE OF BLANK CASING USED:
 1 Steel 3 RMP (SR) 6 Wrought 7 Fiberglass 9 Other (Specify below)
 2 PVC 4 ASB 8 Asbestos-Cement 8 Concrete Tile
 Blank casing diameter 2 in. Was casing pulled? Yes No If yes, how much 3 feet
 Casing height above or below land surface 3 in.

6 GROUT PLUG MATERIAL: 1 Neat cement 2 Cement grout 3 Bentonite 4 Other
 Grout Plug Intervals: From 3 ft. to 181 ft. From ft. to ft. From to ft.
 What is the nearest source of possible contamination:
 1 Septic tank 6 Sewage pit 11 Fuel storage 16 Other (specify below)
 2 Sewer lines 7 Pit privy 12 Fertilizer storage
 3 Watertight sewer lines 8 Sewage lagoon 13 Insecticide storage
 4 Lateral lines 9 Feedyard 14 Abandoned water well
 5 Cess pool 10 Livestock pens 15 Oil well/Gas well
 Direction from well? SW How many feet? 1000

FROM	TO	PLUGGING MATERIALS
0	3	Silty Clay
3	181	Bentonite

7 CONTRACTOR'S OF LANDOWNER'S CERTIFICATION: This water well was plugged under my jurisdiction and was completed on (mo/day/year) 2/18/2013 and this record is true to the best of my knowledge and belief. Kansas Water Well Contractor's License No. 708A This Water Well Record was completed on (mo/day/year) 2/26/2013 under the business name of Aquaterra Environmental Solutions, Inc. by (signature) [Signature]

INSTRUCTIONS: Use typewriter or ball point pen. Please press firmly and print clearly. Please fill in blanks, underline or circle the correct answers. Send top three copies to Kansas Department of Health and Environment, Bureau of Water, Geology Section, 1000 SW Jackson St., Ste. 420, Topeka, Kansas 66612-1367. Telephone: 785/296-5522. Send one to Water Well Owner and retain one for your records.