


1 LOCATION OF WATER WELL: County: Seward	Fraction NE ¼ NE ¼ SE ¼	Section Number 5	Township Number T 35 S	Range Number R 33 E/W
--	-----------------------------------	----------------------------	----------------------------------	---------------------------------

Distance and direction from nearest town or city street address of well if located within city?
138 W. Pancake Blvd., Liberal

2 WATER WELL OWNER: **Wes-Kan Oil Co., Inc.**
 RR#, St. Address, Box # : **138 W. Pancake**
 City, State, ZIP Code : **Liberal, Kansas 67901**
 Board of Agriculture, Division of Water Resources
 Application Number:

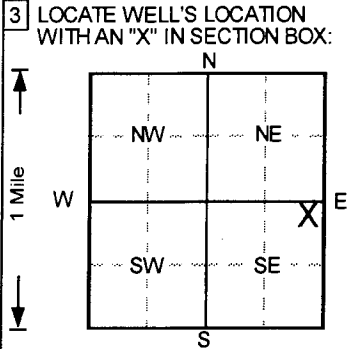

4 DEPTH OF COMPLETED WELL **200** ft ELEVATION: **2841.91**
 Depth(s) Groundwater Encountered 1. ft 2. ft 3. ft
 WELL'S STATIC WATER LEVEL ft below land surface measured on mo/day/yr
 Pump test data: Well water was **NA** ft after hours pumping gpm
 Est. Yield **NA** gpm: Well water was ft after hours pumping gpm
 Bore Hole Diameter **9** in. to **204** ft, and in. to ft
 WELL WATER TO BE USED AS: 5 Public water supply 8 Air conditioning 11 Injection well
 1 Domestic 3 Feedlot 6 Oil field water supply 9 Dewatering 12 Other (Specify below)
 2 Irrigation 4 Industrial 7 Lawn and garden only **10 Monitoring well**
 Was a chemical/bacteriological sample submitted to Department? Yes No ; If yes, mo/day/yr sample was submitted
 Water Well Disinfected? Yes No

5 TYPE OF BLANK CASING USED:
 1 Steel 3 RMP (SR) 5 Wrought iron 8 Concrete tile CASING JOINTS: Glued Clamped
2 PVC 4 ABS 6 Asbestos-Cement 9 Other (specify below) Welded
 7 Fiberglass Threaded.
 Blank casing diameter **4** in. to **150** ft, Dia in. to ft, Dia in. to ft
 Casing height above land surface **-5.28** in., weight lbs./ft. Wall thickness or gauge No. **Sch. 40**
 TYPE OF SCREEN OR PERFORATION MATERIAL
 1 Steel 3 Stainless steel 5 Fiberglass **7 PVC** 10 Asbestos-cement
 2 Brass 4 Galvanized steel 6 Concrete tile 8 RMP (SR) 11 Other (specify)
 9 ABS 12 None used (open hole)
 SCREEN OR PERFORATION OPENINGS ARE:
 1 Continuous slot **3 Mill slot** 5 Gauzed wrapped 8 Saw cut 11 None (open hole)
 2 Louvered shutter 4 Key punched 6 Wire wrapped 9 Drilled holes
 7 Torch cut 10 Other (specify)
 SCREEN-PERFORATED INTERVALS: From **150** ft to **200** ft, From ft to ft
 From ft to ft, From ft to ft
 GRAVEL PACK INTERVALS: From **145** ft to **204** ft, From ft to ft
 From ft to ft, From ft to ft

6 GROUT MATERIAL: 1 Neat cement 2 Cement grout **3 Bentonite** **4 Other Concrete**
 Grout Intervals: From **0** ft to **2** ft, From **2** ft to **145** ft, From ft to ft
 What is the nearest source of possible contamination:
 1 Septic tank 4 Lateral lines 7 Pit privy 10 Livestock pens 14 Abandoned water well
 2 Sewer lines 5 Cess pool 8 Sewage lagoon 11 Fuel storage 15 Oil well/Gas well
 3 Watertight sewer lines 6 Seepage pit 9 Feedyard 12 Fertilizer storage 16 Other (specify below)
 13 Insecticide storage
 Direction from well? How many feet?

FROM	TO	LITHOLOGIC LOG	FROM	TO	PLUGGING INTERVALS
0	6	Clay and Silt, Gray			
6	17	Clay, silty, Lt. Gray Brown			
17	36	Clay, silty to sandy (vf), Lt. Brown			
36	40	Clay, silty to sandy, Lt. Green			
40	58	Clay, silty to slightly sandy, Lt. Brown			
58	76	Clay, silty, Lt. Brown to Tan			
76	98	Clay, silty to sandy (vf), Lt. Brown			
98	108	Clay, silty, v. sl. sandy, Tan			
108	144	Clay, silty, V. Lt. Brown to Tan			
144	160	Caliche, White, w/silt, clay stringers tr. sand			
160	168	Sand, vf-f, w/clay stringers, Tan			
168	182	Clay, caliche stringer, Tan to V. Lt. Brown			
182	204	Sand, vf-c, loose, Tan			MW2R, Flushmount

7 CONTRACTOR'S OR LANDOWNER'S CERTIFICATION: This water well was **1** constructed, (2) reconstructed, or (3) plugged under my jurisdiction and was completed on (mo/day/year) **3/18/2013** and this record is true to the best of my knowledge and belief.
 Kansas Water Well Contractor's License No. **527** This Water Well Record was completed on (mo/day/yr) **3/29/2013**
 under the business name of **GeoCore, Inc.** by (signature) *Dave Bell*

INSTRUCTIONS: Use typewriter or ball point pen. PLEASE PRESS FIRMLY and PRINT clearly. Please fill in blanks, underline or circle the correct answers. Send top three copies to Kansas Department of Health and Environment, Bureau of Water, Topeka, Kansas 66620-0001. Telephone: 913-296-5545. Send one to WATER WELL OWNER and retain one for your records.

OFFICE USE ONLY
T
R
SEC.
¼
¼
¼