WATER WELL PLUGGING RECORD Form WWC-5P KSA 82a-1212 ID NO. MW-1

1 LOCATION OF WATER WELL: County: Seward

Fraction	Section Number	Township Number	Range Number
SE ¼ NW ¼ SW ¼ NE ¼	4	T 35 S	33 ☐ E ☑ W

Street/Rural Address of Well Location; if unknown, distance & direction from nearest town or intersection: If at owner's address, check here ☑ 615 East Cedar Street, Liberal, Kansas

Global Positioning Systems (GPS) information:
Latitude: 37.03472 (in decimal degrees)
Longitude: -100.91139 (in decimal degrees)
Elevation: 2831.21 feet amsl
Datum: ☑ WGS84, ☐ NAD83, ☐ NAD27
Collection Method:
☐ GPS unit (Make/Model: ____
☐ Digital Map/Photo, ☐ Topographic Map, ☑ Land Survey
Est. Accuracy: ☑ < 3 m, ☐ 3-5 m, ☐ 5-15 m, ☐ > 15 m

2 WATER WELL OWNER: Rash Oil Company
RR#, St. Address, Box #: 615 East Cedar Street
City, State ZIP Code: Liberal, Kansas 67905

3 MARK WELL'S LOCATION WITH AN "X" IN SECTION BOX:

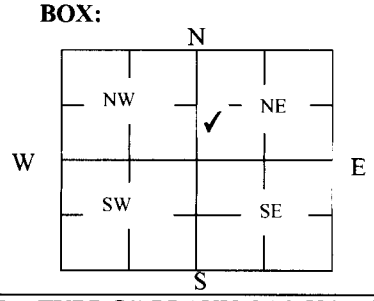

4 DEPTH OF WELL 189.10 ft.
WELL'S STATIC WATER LEVEL 175.99 ft
WELL WAS USED AS:

☐ Domestic ☐ Irrigation ☐ Feedlot ☐ Industrial
☐ Public Water Supply ☐ Oil Field Water Supply ☐ Domestic (Lawn & Garden) ☐ Air Conditioning
☐ Dewatering ☑ Monitoring ☐ Injection Well ☐ Other ____

Was a chemical/bacteriological sample submitted to Department? Yes ☐ No ☑

5 TYPE OF BLANK CASING USED:

☐ Steel ☑ PVC ☐ RMP (SR) ☐ ABS ☐ Wrought ☐ Asbestos-Cement ☐ Fiberglass ☐ Concrete Tile ☐ Other (Specify below) ____

Blank casing diameter 4 in. Was casing pulled? Yes ☑ No ☐ If yes, how much 3 feet
Casing height above or below land surface ____ in.

6 GROUT PLUG MATERIAL: ☐ Neat cement ☐ Cement grout ☑ Bentonite ☐ Other ____

Grout Plug Intervals: From 3 ft. to 189.1 ft., From ____ ft. to ____ ft., From ____ to ____ ft.

What is the nearest source of possible contamination:
☐ Septic tank ☐ Sewer lines ☐ Watertight sewer lines ☐ Lateral lines ☐ Cess pool
☐ Seepage pit ☐ Pit privy ☐ Sewage lagoon ☐ Feedyard ☐ Livestock pens
☑ Fuel Storage ☐ Fertilizer storage ☐ Insecticide storage ☐ Abandoned water well ☐ Oil well/Gas well
☐ Other (specify below) ____
Direction from well? ____
How many feet? ____

FROM	TO	PLUGGING MATERIALS	FROM	TO	PLUGGING MATERIALS
0	3	Native soil/gravel			
3	189.1	Bentonite			

7 CONTRACTOR'S OR LANDOWNER'S CERTIFICATION: This water well was plugged under my jurisdiction and was completed on (mo/day/year) 02/03/2015 and this record is true to the best of my knowledge and belief. Kansas Water Well Contractor's License No. 708. This Water Well Record was completed on (mo/day/year) 02/18/2015 under the business name of SCS Aquaterra by (signature) [signature]

INSTRUCTIONS: Use typewriter or ballpoint pen. Please press firmly and print clearly. Please fill in blanks, underline or circle the correct answers. Send top three copies to Kansas Department of Health and Environment, Bureau of Water, Geology Section, 1000 SW Jackson St., Ste. 420, Topeka, Kansas 66612-1367. Telephone: 785/296-5524. Send one to Water Well Owner and retain one for your records. Visit us at http://www.kdheks.gov/waterwell/index.html.

Check one: ☐ White Copy ☐ Blue Copy ☐ Pink Copy