


WATER WELL PLUGGING RECORD Form WWC-5P KSA 82a-1212 ID NO.

1 LOCATION OF WATER WELL: County: Seward Fraction: NW 1/4 NE 1/4 NE 1/4 NE 1/4 Section Number: 5 Township Number: T 35 S Range Number: 33 [] E [X] W

Street/Rural Address of Well Location; if unknown, distance & direction from nearest town or intersection: If at owner's address, check here [] 124 W. 2nd Street in Liberal.

Global Positioning Systems (GPS) information: Latitude: 37.039445 (in decimal degrees) Longitude: -100.924072 (in decimal degrees) Elevation: Unknown Datum: [] WGS84, [] NAD83, [X] NAD27 Collection Method: [X] GPS unit (Make/Model: WAAS) [] Digital Map/Photo, [] Topographic Map, [] Land Survey Est. Accuracy: [X] < 3 m, [] 3-5 m, [] 5-15 m, [] > 15 m

2 WATER WELL OWNER: KDHE-BER RR#, St. Address, Box #: 1000 SW Jackson City, State ZIP Code: Topeka, KS 66612

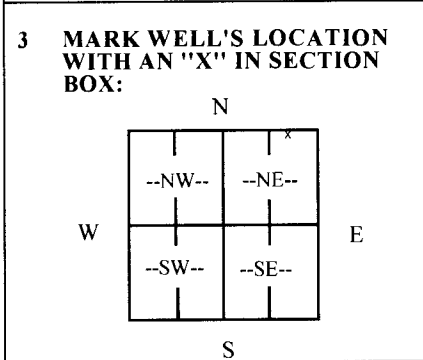

4 DEPTH OF WELL 178.72 ft. WELL'S STATIC WATER LEVEL 175.70 ft. WELL WAS USED AS: [] Domestic [] Public Water Supply [] Dewatering [] Irrigation [] Oil Field Water Supply [X] Monitoring [] Feedlot [] Domestic (Lawn & Garden) [] Injection Well [] Industrial [] Air Conditioning [] Other Was a chemical/bacteriological sample submitted to Department? Yes [] No [X]

5 TYPE OF BLANK CASING USED: [] Steel [] RMP (SR) [] Wrought [] Fiberglass [] Other (Specify below) [X] PVC [] ABS [] Asbestos-Cement [] Concrete Tile Blank casing diameter 4 in. Was casing pulled? Yes [] No [X] If yes, how much Casing height above or below land surface. 36 in.

6 GROUT PLUG MATERIAL: [] Neat cement [] Cement grout [X] Bentonite [] Other Grout Plug Intervals: From 0.5 ft. to 178.72 ft., From _____ ft. to _____ ft., From _____ to _____ ft. What is the nearest source of possible contamination: [] Septic tank [] Seepage pit [] Fuel Storage [X] Other (specify below) None Known [] Sewer lines [] Pit privy [] Fertilizer storage [] Watertight sewer lines [] Sewage lagoon [] Insecticide storage [] Lateral lines [] Feedyard [] Abandoned water well Direction from well? How many feet? [] Cess pool [] Livestock pens [] Oil well/Gas well

Table with 6 columns: FROM, TO, PLUGGING MATERIALS, FROM, TO, PLUGGING MATERIALS. Row 1: 0, 0.5, Cement. Row 2: 0.5, 15, Bentonite Chips. Row 3: 15, 178.72, 20% Solids Bentonite Grout.

7 CONTRACTOR'S OR LANDOWNER'S CERTIFICATION: This water well was plugged under my jurisdiction and was completed on (mo/day/year) 09/07/17 and this record is true to the best of my knowledge and belief. Kansas Water Well Contractor's License No. 185. This Water Well Record was completed on (mo/day/year) 09/12/17 under the business name of Clarke Well & Equipment, Inc. by (signature) [Signature]

INSTRUCTIONS: Use typewriter or ballpoint pen. Please press firmly and print clearly. Please fill in blanks, underline or circle the correct answers. Send top three copies to Kansas Department of Health and Environment, Bureau of Water, Geology Section, 1000 SW Jackson St., Ste. 420, Topeka, Kansas 66612-1367. Telephone: 785/296-5524. Send one to Water Well Owner and retain one for your records. Visit us at http://www.kdheks.gov/waterwell/1~ndex.html.