

WATER WELL RECORD Form WWC-5


Division of Water
Resources App. No.

Well ID **WMW14**

Original Record Correction Change in Well Use

1 LOCATION OF WATER WELL: Fraction **NE 1/4 SW 1/4 SW 1/4 NW 1/4** Section Number **4** Township Number **T 35 S** Range Number **R 33** E W
County: **Seward**

2 WELL OWNER: Last Name: **Larry Weaver** First: _____ Street or Rural Address where well is located (if unknown, distance and direction from nearest town or intersection): If at owner's address, check here:
Business: **Larry Weaver** Address: **1105 Westhaven Dr.** City: **Liberal** State: **KS** ZIP: **67901**
Address: _____ City: _____ State: _____ ZIP: _____
City: **Liberal** State: **KS** ZIP: **67901** Street or Rural Address where well is located (if unknown, distance and direction from nearest town or intersection): **409 S. Washington, Liberal**

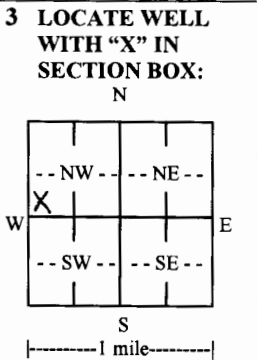

4 DEPTH OF COMPLETED WELL: **210** ft.
Depth(s) Groundwater Encountered: 1) ft.
2) ft. 3) ft., or 4) Dry Well
WELL'S STATIC WATER LEVEL: **184.14** ft.
 below land surface, measured on (mo-day-yr) **8/2/19**
 above land surface, measured on (mo-day-yr)
Pump test data: Well water was ft.
after hours pumping gpm
Well water was ft.
after hours pumping gpm
Estimated Yield: gpm
Bore Hole Diameter: **8.75** in. to **213** ft. and
..... in. to ft.

5 Latitude: **37.03371** (decimal degrees)
Longitude: **-100.92105** (decimal degrees)
Horizontal Datum: WGS 84 NAD 83 NAD 27
Source for Latitude/Longitude:
 GPS (unit make/model: **iGage iG8 Base/Rover**)
(WAAS enabled? Yes No)
 Land Survey Topographic Map
 Online Mapper:

6 Elevation: **2836.87** ft. Ground Level TOC
Source: Land Survey GPS Topographic Map
 Other

7 WELL WATER TO BE USED AS:

1. Domestic: Household Lawn & Garden Livestock
2. Irrigation
3. Feedlot
4. Industrial

5. Public Water Supply: well ID

6. Dewatering: how many wells?

7. Aquifer Recharge: well ID

8. Monitoring: well ID **WMW14**

9. Environmental Remediation: well ID

Air Sparge Soil Vapor Extraction
 Recovery Injection

10. Oil Field Water Supply: lease

11. Test Hole: well ID

Cased Uncased Geotechnical

12. Geothermal: how many bores?

a) Closed Loop Horizontal Vertical
b) Open Loop Surface Discharge Inj. of Water

13. Other (specify):

Was a chemical/bacteriological sample submitted to KDHE? Yes No If yes, date sample was submitted:

Water well disinfected? Yes No

8 TYPE OF CASING USED: Steel PVC Other CASING JOINTS: Glued Clamped Welded Threaded
Casing diameter **4** in. to **180** ft., Diameter in. to ft., Diameter in. to ft.
Casing height above land surface **4.8** in. Weight lbs./ft. Wall thickness or gauge No. **Sch. 80**

TYPE OF SCREEN OR PERFORATION MATERIAL:
 Steel Stainless Steel Fiberglass PVC Other (Specify)
 Brass Galvanized Steel Concrete tile None used (open hole)

SCREEN OR PERFORATION OPENINGS ARE:
 Continuous Slot Mill Slot Gauze Wrapped Torch Cut Drilled Holes Other (Specify)
 Louvered Shutter Key Punched Wire Wrapped Saw Cut None (Open Hole)

SCREEN-PERFORATED INTERVALS: From **180** ft. to **210** ft., From ft. to ft., From ft. to ft.
GRAVEL PACK INTERVALS: From **175** ft. to **213** ft., From ft. to ft., From ft. to ft.

9 GROUT MATERIAL: Neat cement Cement grout Bentonite Other **Concrete**

Grout Intervals: From **0** ft. to **1** ft., From **1** ft. to **175** ft., From ft. to ft.

Nearest source of possible contamination:
 Septic Tank Lateral Lines Pit Privy Livestock Pens Insecticide Storage
 Sewer Lines Cess Pool Sewage Lagoon Fuel Storage Abandoned Water Well
 Watertight Sewer Lines Seepage Pit Feedyard Fertilizer Storage Oil Well/Gas Well
 Other (Specify) **Contaminated site**

Direction from well? Distance from well? ft.

| 10 FROM | TO | LITHOLOGIC LOG | FROM | TO | LITHO. LOG (cont.) or PLUGGING INTERVALS |
|---------|-----|--|---------------|-----|--|
| 0 | 5 | Hydroexcavated - No Sample | 113 | 133 | Clay, silty, sandy, Lt. Yel Brn to Yel Brn |
| 5 | 23 | Sand, vf-f, Yellow Brown | 133 | 142 | Clay, sandy |
| 23 | 43 | Sand, vf-f, Yel Brown w/Lt. Brown Clay | 142 | 154 | Caliche, sandy, V. Pale Brown |
| 43 | 64 | Clay, silty, sandy | 154 | 167 | Clay, sandy w/thin sand stringers |
| 64 | 78 | Clay, sandy, Lt. Brn to Lt. Yel Brn | 167 | 196 | Clay, sandy w/SS stringers (vf-f) |
| 78 | 83 | Sand, vf-c, w/clay stringers, Lt. Brn | 196 | 213 | Sand, vf-c, w/Lt. Gry Brn clay stringers |
| 83 | 95 | Clay, sandy | Notes: | | |
| 95 | 105 | Clay, silty, sandy, Lt. Yel Brn to Lt. Brn | | | |
| 105 | 113 | Clay, sandy, Yel Brn w/Pale Brn | | | |

11 CONTRACTOR'S OR LANDOWNER'S CERTIFICATION: This water well was constructed, reconstructed, or plugged under my jurisdiction and was completed on (mo-day-year) **8/29/2019** and this record is true to the best of my knowledge and belief. Kansas Water Well Contractor's License No. **527** This Water Well Record was completed on (mo-day-year) **9/4/2019** under the business name of **GeoCore, LLC** Signature *[Signature]*