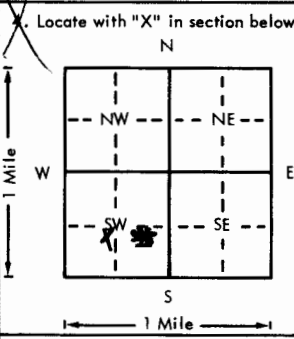


USE TYPEWRITER OR BALL POINT PEN—PRESS FIRMLY, PRINT CLEARLY.

WATER WELL RECORD
KSA 82a-1201-1215

Kansas Department of Health and Environment—Division of Environment
(Water well Contractors)
Topeka, Kansas 66620

1. Location of well:		County Seward	Section NE 1/4 SW 1/4 SW 1/4	Section number 8	Township number T 35 S R 33	Range number 33																					
2. Distance and direction from nearest town or city: Street address of well location if in city: 3/4 S, Liberal			3. Owner of well: Paul King R.R. or street: Liberal, Kansas City, state, zip code:																								
4. Locate with "X" in section below: 		Sketch map:		6. Bore hole dia. 9 7/8 in. Completion date 12-16-75 Well depth 253 ft.																							
5. Type and color of material <table border="1" style="width:100%; border-collapse: collapse;"> <thead> <tr> <th></th> <th>From</th> <th>To</th> </tr> </thead> <tbody> <tr> <td>Top soil</td> <td>0</td> <td>5</td> </tr> <tr> <td>Tan clay</td> <td>5</td> <td>42</td> </tr> <tr> <td>Brown clay</td> <td>42</td> <td>50</td> </tr> <tr> <td>Tan clay & sandy</td> <td>50</td> <td>132</td> </tr> <tr> <td>Tan & white clay</td> <td>132</td> <td>190</td> </tr> <tr> <td>Tan clay with med. to lar. sand & gravel</td> <td>190</td> <td>260</td> </tr> </tbody> </table>					From	To	Top soil	0	5	Tan clay	5	42	Brown clay	42	50	Tan clay & sandy	50	132	Tan & white clay	132	190	Tan clay with med. to lar. sand & gravel	190	260	7. <input type="checkbox"/> Cable tool <input checked="" type="checkbox"/> Rotary <input type="checkbox"/> Driven <input type="checkbox"/> Dug <input type="checkbox"/> Hollow rod <input type="checkbox"/> Jetted <input type="checkbox"/> Bored <input type="checkbox"/> Reverse rotary		
8. Use: <input type="checkbox"/> Domestic <input type="checkbox"/> Public supply <input type="checkbox"/> Industry <input type="checkbox"/> Irrigation <input type="checkbox"/> Air conditioning <input checked="" type="checkbox"/> Stock <input type="checkbox"/> Lawn <input type="checkbox"/> Oil field water <input type="checkbox"/> Other																											
9. Casing: Material RMP Height: Above or below Threaded <input type="checkbox"/> Welded <input checked="" type="checkbox"/> Surface 24 in. RMP <input type="checkbox"/> PVC <input type="checkbox"/> Weight 220 lbs./ft. Dia. 5 in. to 253 ft. depth Wall Thickness: inches or Dia. <input type="checkbox"/> in. to <input type="checkbox"/> ft. depth gage No. 320																											
10. Screen: Manufacturer's name Jess & Lowell Type RMP Dia. 5" Slot/gauze 1/8" Length 60' Set between 193 ft. and 253 ft. <input type="checkbox"/> ft. and <input type="checkbox"/> ft. Gravel pack? yes Size range of material 3/16"																											
11. Static water level: <input type="checkbox"/> mo./day/yr. 95 ft. below land surface Date 12/13/75																											
12. Pumping level below land surfaces: <input type="checkbox"/> ft. after <input type="checkbox"/> hrs. pumping <input type="checkbox"/> g.p.m. <input type="checkbox"/> ft. after <input type="checkbox"/> hrs. pumping <input type="checkbox"/> g.p.m. Estimated maximum yield <input type="checkbox"/> g.p.m.																											
13. Water sample submitted: <input type="checkbox"/> mo./day/yr. <input type="checkbox"/> Yes <input checked="" type="checkbox"/> No Date																											
14. Well head completion: <input type="checkbox"/> Pitless adapter 18 Inches above grade																											
15. Well grouted? yes With: <input type="checkbox"/> Neat cement <input type="checkbox"/> Bentonite <input checked="" type="checkbox"/> Concrete Depth: From 0 ft. to 10 ft.																											
16. Nearest source of possible contamination: ft. 100 Direction West Type corral Well disinfected upon completion? <input checked="" type="checkbox"/> Yes <input type="checkbox"/> No																											
17. Pump: 8' Windmill Not installed Manufacturer's name Aermotor Model number _____ HP _____ Volts _____ Length of drop pipe _____ ft. capacity 2 g.p.m. Type: <input type="checkbox"/> Submersible <input type="checkbox"/> Turbine <input type="checkbox"/> Jet <input type="checkbox"/> Reciprocating <input type="checkbox"/> Centrifugal Windmill Other																											
18. Elevation:		20. Water well contractor's certification: This well was drilled under my jurisdiction and this report is true to the best of my knowledge and belief. Eriesen Windmill 252 Business name License No. Address Meade, Kansas Signed John Eriesen Date _____ Authorized representative																									
19. Remarks:		(Use a second sheet if needed) <div style="float: right; text-align: right; font-size: small;"> Sec 1/4 NE 1/4 SW 1/4 </div>																									

Forward the white, blue and pink copies to the Department of Health and Environment

Form WWC-5