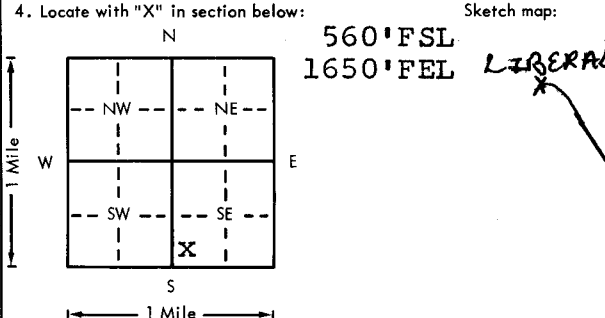
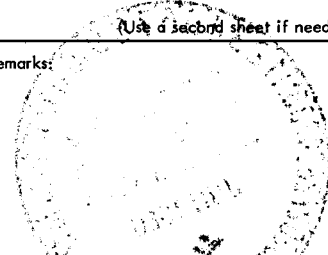


USE TYPEWRITER OR BALL POINT PEN-PRESS FIRMLY, PRINT CLEARLY.

WATER WELL RECORD
KSA 82a-1201-1215

Kansas Department of Health and Environment-Division of Environment (Water well Contractors) Topeka, Kansas 66620

1. Location of well:	County Seward	Fraction SE 1/4 SW 1/4 SE 1/4	Section number 9	Township number T 35 S R	Range number 33W E/W
2. Distance and direction from nearest town or city: 2 miles south-east of Liberal. Street address of well location in city:			3. Owner of well: Carlile Water Well Service R.R. or street: Box 275 City, state, zip code: Liberal, Kansas 67901		
4. Locate with "X" in section below: Sketch map: 			6. Bore hole dia. 11 in. Completion date 12-19 Well depth 280 ft.		
5. Type and color of material			7. <input type="checkbox"/> Cable tool <input checked="" type="checkbox"/> Rotary <input type="checkbox"/> Driven <input type="checkbox"/> Dug <input type="checkbox"/> Hollow rod <input type="checkbox"/> Jetted <input type="checkbox"/> Bored <input type="checkbox"/> Reverse rotary		
			8. Use: <input type="checkbox"/> Domestic <input type="checkbox"/> Public supply <input checked="" type="checkbox"/> Industry <input type="checkbox"/> Irrigation <input type="checkbox"/> Air conditioning <input type="checkbox"/> Stock <input type="checkbox"/> Lawn <input type="checkbox"/> Oil field water <input type="checkbox"/> Other		
From To			9. Casing: Material _____ Height: <u>Above</u> or below Threaded _____ Welded _____ Surface 18 in. RMP _____ PVC <input checked="" type="checkbox"/> Weight 2.78 lbs./ft. Dia. 5 in. to 229 ft. depth Wall Thickness: inches or Dia. 5 in. to 280 ft. depth gage No. 265		
			10. Screen: Manufacturer's name Wesco Type PVC Dia. 5" Slot/gauze .030 Length 19' Set between 229 ft. and 239 ft. 261 ft. and 270 ft.		
Surface 0 2			11. Static water level: _____ mo./day/yr. 131 ft. below land surface Date 12-19-77		
			12. Pumping level below land surfaces: 132 ft. after 12 hrs. pumping 50 g.p.m. _____ ft. after _____ hrs. pumping _____ g.p.m. Estimated maximum yield 100 g.p.m.		
Fine sand 2 18			13. Water sample submitted: _____ mo./day/yr. <input type="checkbox"/> Yes <input checked="" type="checkbox"/> No Date _____		
			14. Well head completion: <input type="checkbox"/> Pitless adapter 18 Inches above grade		
Sandy clay 18 120			15. Well grouted? yes With: <input checked="" type="checkbox"/> Neat cement <input type="checkbox"/> Bentonite <input type="checkbox"/> Concrete Depth: From 3 ft. to 20 ft.		
			16. Nearest source of possible contamination: Septic ft. 300 Direction South Type Tank Well disinfected upon completion? <input checked="" type="checkbox"/> Yes <input type="checkbox"/> No		
Clay & Fine Sand 70-30 120 150			17. Pump: _____ Not installed Manufacturer's name Goulds Model number UTM504 HP 5 Volts 230 Length of drop pipe 210 ft. capacity 50 g.p.m. Type: <input checked="" type="checkbox"/> Submersible <input type="checkbox"/> Turbine <input type="checkbox"/> Jet <input type="checkbox"/> Reciprocating <input type="checkbox"/> Centrifugal <input type="checkbox"/> Other		
			20. Water well contractor's certification: This well was drilled under my jurisdiction and this report is true to the best of my knowledge and belief. Carlile Water Well 118 Business name License No. Address Box 275, Liberal, KS Signed Edward E. Meaner Date 12-30 Authorized representative		
18. Elevation: 2834			19. Remarks: 		
Topography: <input type="checkbox"/> Hill <input type="checkbox"/> Slope <input checked="" type="checkbox"/> Upland <input type="checkbox"/> Valley					

T 35 S R 33 W 9 SE 1/4

Forward the white, blue and pink copies to the Department of Health and Environment

Form WWC-5

USE TYPEWRITER OR BALL POINT PEN—PRESS FIRMLY, PRINT CLEARLY.

WATER WELL RECORD
KSA 82a-1201-1215

Kansas Department of Health and Environment—Division of Environment (Water well Contractors)
Topeka, Kansas 66620

1. Location of well:		County Seward	Fraction SE 1/4 SW 1/4 SE 1/4	Section number 9	Township number T 35 S R	Range number 33W E/W	
2. Distance and direction from nearest town or city: 2 miles south-east of Liberal. Street address of well location in city:			3. Owner of well: Carlile Water Well Service R.R. or street: Box 275 City, state, zip code: Liberal, Kansas 67901				
4. Locate with "X" in section below: N 560' FSL 1650' FEL LIBERAL Sketch map: LIBERAL APPR. 2m. SE OF LIBERAL KANSAS			6. Bore hole dia. 11 in. Completion date 12-19 Well depth 280 ft.				
			7. <input type="checkbox"/> Cable tool <input checked="" type="checkbox"/> Rotary <input type="checkbox"/> Driven <input type="checkbox"/> Dug <input type="checkbox"/> Hollow rod <input type="checkbox"/> Jetted <input type="checkbox"/> Bored <input type="checkbox"/> Reverse rotary				
			8. Use: <input type="checkbox"/> Domestic <input type="checkbox"/> Public supply <input checked="" type="checkbox"/> Industry <input type="checkbox"/> Irrigation <input type="checkbox"/> Air conditioning <input type="checkbox"/> Stock <input type="checkbox"/> Lawn <input type="checkbox"/> Oil field water <input type="checkbox"/> Other				
5. Type and color of material			From	To	9. Casing: Material _____ Height: <u>Above</u> or below Threaded _____ Welded _____ Surface <u>18</u> in. RMP _____ PVC <input checked="" type="checkbox"/> Weight <u>2.78</u> lbs./ft. Dia. <u>5</u> in. to <u>229</u> ft. depth Wall Thickness: inches or Dia. <u>5</u> in. to <u>280</u> ft. depth gage No. <u>265</u>		
Surface			0	2	10. Screen: Manufacturer's name <u>Wesco</u> Type <u>PVC</u> Dia. <u>5"</u> Slot/gauze <u>.030</u> Length <u>19'</u> Set between <u>229</u> ft. and <u>239</u> ft. <u>261</u> ft. and <u>270</u> ft.		
Fine sand			2	18	11. Static water level: _____ mo./day/yr. <u>131</u> ft. below land surface Date <u>12-19-77</u>		
Sandy clay			18	120	12. Pumping level below land surfaces: <u>132</u> ft. after <u>12</u> hrs. pumping <u>50</u> g.p.m. _____ ft. after _____ hrs. pumping _____ g.p.m. Estimated maximum yield <u>100</u> g.p.m.		
Clay & Fine Sand 70-30			120	150	13. Water sample submitted: _____ mo./day/yr. <input type="checkbox"/> Yes <input checked="" type="checkbox"/> No Date _____		
Fine sand & Medium to small sand			150	260	14. Well head completion: <input type="checkbox"/> Pitless adapter <u>18</u> Inches above grade		
Clay 20% & Medium sand			260	280	15. Well grouted? <u>yes</u> With: <input checked="" type="checkbox"/> Neat cement <input type="checkbox"/> Bentonite <input type="checkbox"/> Concrete Depth: From <u>3</u> ft. to <u>20</u> ft.		
					16. Nearest source of possible contamination: <u>Septic</u> ft. <u>300</u> Direction <u>South</u> Type <u>Tank</u> Well disinfected upon completion? <input checked="" type="checkbox"/> Yes <input type="checkbox"/> No		
					17. Pump: _____ Not installed Manufacturer's name <u>Goulds</u> Model number <u>UTM504</u> HP <u>5</u> Volts <u>230</u> Length of drop pipe <u>210</u> ft. capacity <u>50</u> g.p.m. Type: <input checked="" type="checkbox"/> Submersible <input type="checkbox"/> Turbine <input type="checkbox"/> Jet <input type="checkbox"/> Reciprocating <input type="checkbox"/> Centrifugal <input type="checkbox"/> Other		
18. Elevation: 2834			19. Remarks: (Use a second sheet if needed)			20. Water well contractor's certification: This well was drilled under my jurisdiction and this report is true to the best of my knowledge and belief. Carlile Water Well 118 Business name License No. Address Box 275, Liberal, KS Signed <u>Edward E. Meador</u> Date <u>12-30</u> Authorized representative	

T 35 S R 33 W 9 SE 1/4

Forward the white, blue and pink copies to the Department of Health and Environment

Form WWC-5