


1 LOCATION OF WATER WELL: Fraction NW 1/4 NW 1/4 NW 1/4 Section Number 9 Township Number T 35 S Range Number R 33 EW
 County: SEWARD

Distance and direction from nearest town or city street address of well if located within city?
905 S. KANSAS AVE., Liberal, KANSAS MW-1

2 WATER WELL OWNER: JIM MADDEN
 RR#, St. Address, Box #: P.O. BOX 148 Board of Agriculture, Division of Water Resources
 City, State, ZIP Code: Liberal, KANSAS 67905-0148 Application Number:

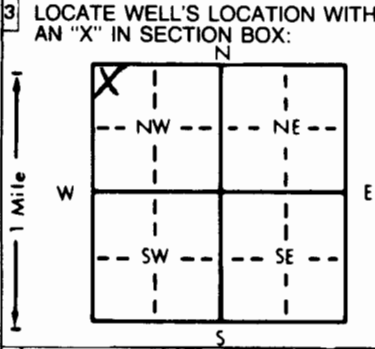

4 DEPTH OF COMPLETED WELL: 155 ft. ELEVATION:
 Depth(s) Groundwater Encountered 1. 151 ft. 2. _____ ft. 3. _____ ft.
 WELL'S STATIC WATER LEVEL 151.27 ft. below land surface measured on mo/day/yr 4-5-95
 Pump test data: Well water was _____ ft. after _____ hours pumping _____ gpm
 Est. Yield _____ gpm: Well water was _____ ft. after _____ hours pumping _____ gpm
 Bore Hole Diameter _____ in. to _____ ft., and _____ in. to _____ ft.
 WELL WATER TO BE USED AS:
 5 Public water supply 8 Air conditioning 11 Injection well
 1 Domestic 3 Feedlot 6 Oil field water supply 9 Dewatering 12 Other (Specify below)
 2 Irrigation 4 Industrial 7 Lawn and garden only 10 Monitoring well
 Was a chemical/bacteriological sample submitted to Department? Yes No; If yes, mo/day/yr sample was sub-
 mitted Water Well Disinfected? Yes No

5 TYPE OF BLANK CASING USED:
 1 Steel 3 RMP (SR) 5 Wrought iron 8 Concrete tile CASING JOINTS: Glued _____ Clamped _____
2 PVC 4 ABS 6 Asbestos-Cement 9 Other (specify below) Welded _____
 7 Fiberglass Threaded _____
 Blank casing diameter 4 in. to 125 ft., Dia _____ in. to _____ ft., Dia _____ in. to _____ ft.
 Casing height above land surface _____ in., weight _____ lbs./ft. Wall thickness or gauge No. _____
 TYPE OF SCREEN OR PERFORATION MATERIAL:
 1 Steel 3 Stainless steel 5 Fiberglass 8 RMP (SR) 10 Asbestos-cement
 2 Brass 4 Galvanized steel 6 Concrete tile 9 ABS 11 Other (specify) _____
 12 None used (open hole)
 SCREEN OR PERFORATION OPENINGS ARE:
 1 Continuous slot 3 Mill slot 5 Gauzed wrapped 8 Saw cut 11 None (open hole)
 2 Louvered shutter 4 Key punched 6 Wire wrapped 9 Drilled holes
 7 Torch cut 10 Other (specify) _____
 SCREEN-PERFORATED INTERVALS: From 155 ft. to 125 ft., From _____ ft. to _____ ft.
 From _____ ft. to _____ ft., From _____ ft. to _____ ft.
 GRAVEL PACK INTERVALS: From 123 ft. to 155 ft., From _____ ft. to _____ ft.
 From _____ ft. to _____ ft., From _____ ft. to _____ ft.

6 GROUT MATERIAL: 1 Neat cement 2 Cement grout 3 Bentonite 4 Other _____
 Grout Intervals: From 2.25 ft. to 121 ft., From 121 ft. to 123 ft., From _____ ft. to _____ ft.
 What is the nearest source of possible contamination:
 1 Septic tank 4 Lateral lines 7 Pit privy 10 Livestock pens 14 Abandoned water well
 2 Sewer lines 5 Cess pool 8 Sewage lagoon 11 Fuel storage 15 Oil well/Gas well
 3 Watertight sewer lines 6 Seepage pit 9 Feedyard 12 Fertilizer storage 16 Other (specify below)
 13 Insecticide storage
 Direction from well? EAST How many feet? 1

FROM	TO	LITHOLOGIC LOG	FROM	TO	PLUGGING INTERVALS
0'	0.5'	Gravel			
0.5'	10'	Clay, some silt, moderate brown			
10'	15'	Sand, fine, moderate brown			
15'	30'	Clay, low plasticity, moderate brown			
30'	35'	Silty clay, low plasticity, moderate brown			
35'	50'	Sand, fine, pale yellowish brown			
50'	58'	Clay, low plasticity, moderate brown			
58'	68'	Sand, fine, pale yellowish brown			
68'	88'	Clay, low plasticity, pale brown			
88'	108'	Sand, fine to medium, pale brown			
108'	118'	Sand, low plasticity, med. brown			
118'	128'	Sand, fine to medium, pale brown			
128'	155'	Clay, stiff, highly plastic, pale brown			

7 CONTRACTOR'S OR LANDOWNER'S CERTIFICATION: This water well was (1) constructed, (2) reconstructed, or (3) plugged under my jurisdiction and was completed on (mo/day/year) 2-4-95 and this record is true to the best of my knowledge and belief. Kansas Water Well Contractor's License No. 438 This Water Well Record was completed on (mo/day/yr) 2-9-95 under the business name of KANSAS CITY TESTING by (signature) Bernie Tome

OFFICE USE ONLY
T
R
EW
SEC.
1/4
1/4
1/4