

**CORRECTION(S) TO WATER WELL RECORD (WWC-5)**  
(to rectify lacking or incorrect information)

County: Seward

Location listed as:

Location ~~changed to:~~

Section-Township-Range: \_\_\_\_\_

6-355-34W

Fraction (  $\frac{1}{4}$   $\frac{1}{4}$   $\frac{1}{4}$  ): \_\_\_\_\_

NW NW NE

Other changes: Initial statements: Stevens County

Changed to: Seward County

Comments: \_\_\_\_\_

verification method: Written & legal descriptions, and  
Liberal & Woods SE 1:24,000 topo. maps.


initials: DRL date: 3/9/2005

submitted by: Kansas Geological Survey, Data Resources Library, 1930 Constant Ave., Lawrence, KS 66047-3726  
to: Kansas Dept of Health & Environment, Bureau of Water, 1000 SW Jackson, Suite 420, Topeka, KS 66612-1367.

1 LOCATION OF WATER WELL: County: **STEPHENS** Fraction: **NE 1/4 NW 1/4 NE 1/4** Section Number: **6** Township Number: **T 35 S** Range Number: **R 34 E/W**

Distance and direction from nearest town or city street address of well if located within city?  
**10 mi. W of Liberal**

2 WATER WELL OWNER: **DARWIN CASEBEER**  
 RR#, St. Address, Box #: **Rt 1 Box 48A**  
 City, State, ZIP Code: **Nowata, KS 67951**  
 Board of Agriculture, Division of Water Resources  
 Application Number:

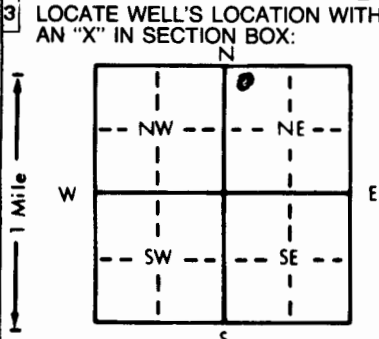

4 DEPTH OF COMPLETED WELL: **640** ft. ELEVATION: \_\_\_\_\_ ft.  
 Depth(s) Groundwater Encountered: 1. **200** ft. 2. \_\_\_\_\_ ft. 3. \_\_\_\_\_ ft.  
 WELL'S STATIC WATER LEVEL: **200** ft. below land surface measured on **mo/day/yr 4-22-98**  
 Pump test data: Well water was **118** ft. after **1** hours pumping **1700** gpm  
 Est. Yield \_\_\_\_\_ gpm: Well water was \_\_\_\_\_ ft. after \_\_\_\_\_ hours pumping \_\_\_\_\_ gpm  
 Bore Hole Diameter: **25** in. to **640** ft., and \_\_\_\_\_ in. to \_\_\_\_\_ ft.  
 WELL WATER TO BE USED AS:  
 1 Domestic  3 Feedlot  6 Oil field water supply  9 Dewatering  12 Other (Specify below)  
 2 Irrigation  4 Industrial  7 Lawn and garden only  10 Monitoring well  
 Was a chemical/bacteriological sample submitted to Department? Yes \_\_\_\_\_ No  If yes, mo/day/yr sample was submitted \_\_\_\_\_  
 Water Well Disinfected? Yes  No \_\_\_\_\_

5 TYPE OF BLANK CASING USED:  
 1 Steel  3 RMP (SR)  5 Wrought iron  8 Concrete tile CASING JOINTS: Glued \_\_\_\_\_ Clamped \_\_\_\_\_  
 2 PVC  4 ABS  6 Asbestos-Cement  9 Other (specify below) Welded   
 7 Fiberglass Threaded \_\_\_\_\_  
 Blank casing diameter: **16** in. to **230** ft., Dia: **16** in. to **630-640** ft., Dia: \_\_\_\_\_ in. to \_\_\_\_\_ ft.  
 Casing height above land surface: **24** in., weight \_\_\_\_\_ lbs./ft. Wall thickness or gauge No. **250**  
 TYPE OF SCREEN OR PERFORATION MATERIAL:  
 1 Steel  3 Stainless steel  5 Fiberglass  8 RMP (SR)  10 Asbestos-cement  
 2 Brass  4 Galvanized steel  6 Concrete tile  9 ABS  12 None used (open hole)  
 SCREEN OR PERFORATION OPENINGS ARE:  
 1 Continuous slot  3 Mill slot  5 Gauzed wrapped  8 Saw cut  11 None (open hole)  
 2 Louvered shutter  4 Key punched  6 Wire wrapped  9 Drilled holes  
 7 Torch cut  10 Other (specify) \_\_\_\_\_  
 SCREEN-PERFORATED INTERVALS: From **230** ft. to **550** ft., From \_\_\_\_\_ ft. to \_\_\_\_\_ ft.  
 From **550** ft. to **630** ft., From \_\_\_\_\_ ft. to \_\_\_\_\_ ft.  
 GRAVEL PACK INTERVALS: From **10** ft. to **640** ft., From \_\_\_\_\_ ft. to \_\_\_\_\_ ft.  
 From \_\_\_\_\_ ft. to \_\_\_\_\_ ft., From \_\_\_\_\_ ft. to \_\_\_\_\_ ft.

6 GROUT MATERIAL:  1 Neat cement  2 Cement grout  3 Bentonite  4 Other \_\_\_\_\_  
 Grout Intervals: From **10** ft. to **0** ft., From \_\_\_\_\_ ft. to \_\_\_\_\_ ft., From \_\_\_\_\_ ft. to \_\_\_\_\_ ft.  
 What is the nearest source of possible contamination:  
 1 Septic tank  4 Lateral lines  7 Pit privy  10 Livestock pens  14 Abandoned water well  
 2 Sewer lines  5 Cess pool  8 Sewage lagoon  11 Fuel storage  15 Oil well/Gas well  
 3 Watertight sewer lines  6 Seepage pit  9 Feedyard  12 Fertilizer storage  16 Other (specify below)  
 13 Insecticide storage  
 Direction from well? **SOUTH** How many feet? **2630**

FROM	TO	LITHOLOGIC LOG	FROM	TO	PLUGGING INTERVALS
0	200	SURFACE SAND + CLAY			
200	308	FINE TO MED. SAND w/ CLAY STRIPS			
308	363	SANDSTONE w/ SAND STRIPS			
363	630	FINE TO MED SAND w/ CLAY STRIPS			
630	640	Blue + Red Clay			

7 CONTRACTOR'S OR LANDOWNER'S CERTIFICATION: This water well was  (1) constructed, (2) reconstructed, or (3) plugged under my jurisdiction and was completed on (mo/day/year) **5-7-98** and this record is true to the best of my knowledge and belief. Kansas Water Well Contractor's License No. **548** This Water Well Record was completed on (mo/day/yr) **5-13-98** under the business name of **LES TAYLOR DRILLING** by (signature) *[Signature]*