


1 LOCATION OF WATER WELL: Fraction NE 1/4 NE 1/4 SE 1/4 Section Number 14 Township Number 35 S Range Number 34 (E/W)
 County: Seward

Distance and direction from nearest town or city street address of well if located within city?
Liberal: Hwy 54 and Western go W on Hwy 54

2 WATER WELL OWNER: Max Jantz Excavating Llc
 RR #, St. Address, Box #: 26503 Eleven Road Board of Agriculture, Division of Water Resources
 City, State, ZIP Code: Montezuma, Ks 67867 Application Number: _____

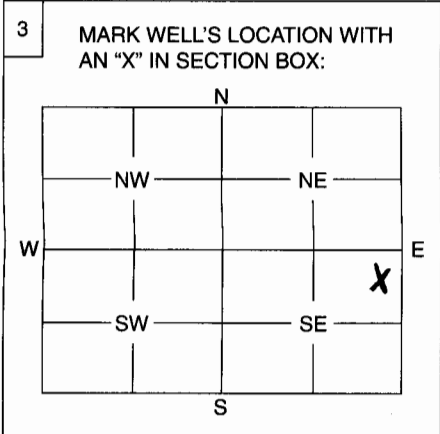

4 DEPTH OF WELL 248 ft.
 WELL'S STATIC WATER LEVEL 116 ft.
 WELL WAS USED AS:
 1 Domestic 5 Public Water Supply 9 Dewatering
 2 Irrigation 6 Oil Field Water Supply 10 Monitoring Well
 3 Feedlot 7 Domestic (Lawn & Garden) 11 Injection Well
 4 Industrial 8 Air Conditioning 12 Other

Was a chemical / bacteriological sample submitted to Department? Yes No
 If yes, mo/day/yr sample was submitted

Water Well Disinfected: Yes No

5 TYPE OF BLANK CASING USED:
 1 Steel 3 RMP (SR) 5 Wrought 7 Fiberglass 9 Other (Specify below)
 2 PVC 4 ABS 6 Asbestos-Cement 8 Concrete Tile

Blank casing diameter 5 in. Was casing pulled? Yes No If yes, how much

Casing height above or below land surface 48 in.

6 GROUT PLUG MATERIAL: ~~1~~ Neat cement Cement grout 3 Bentonite 4 Other

Grout Plug Intervals: 248 From ft. to 4 ft., From ft. to ft., From to ft.

What is the nearest source of possible contamination:
 1 Septic tank 6 Seepage pit 11 Fuel storage 16 Other (specify below)
 2 Sewer lines 7 Pit privy 12 Fertilizer storage

3 Watertight sewer lines 8 Sewage lagoon 13 Insecticide storage
 4 Lateral lines 9 Feedyard 14 Abandoned water well
 5 Cess pool 10 Livestock pens 15 Oil well/Gas well

Direction from well? How many feet?

FROM	TO	PLUGGING MATERIALS
<u>248</u>	<u>4</u>	<u>Cement Grout</u>
<u>4</u>	<u>Surface</u>	<u>Backfill</u>

7 CONTRACTOR'S OF LANDOWNER'S CERTIFICATION: This water well was plugged under my jurisdiction and was completed on (mo/day/year) 10-16-06 and this record is true to the best of my knowledge and belief. Kansas Water Well Contractor's License No. KWWCL-130 This Water Well Record was completed on (mo/day/year) 10-16-06 under the business name of Howard Drilling Co Box 806 Beaver, Ok 73932
 by (signature) [Signature]

INSTRUCTIONS: Use typewriter or ball point pen. Please press firmly and print clearly. Please fill in blanks, underline or circle the correct answers. Send top three copies to Kansas Department of Health and Environment, Bureau of Water, Geology Section, 1000 SW Jackson St., Ste. 420, Topeka, Kansas 66612-1367. Telephone: 785/296-5522. Send one to Water Well Owner and retain one for your records.