


1	LOCATION OF WATER WELL:	Fraction	Section Number	Township Number	Range Number
County: Seward		SW ¼ SW ¼ SW ¼	14	35S	34

EW

Distance and direction from nearest town or city street address of well if located within city?
 Liberal: SW on 54 to Oklahoma State Line and S into--

2	WATER WELL OWNER:	Jimmie Rogers Livestock			
	RR #, St. Address, Box #:	Rt. 1, Box 51		Board of Agriculture, Division of Water Resources	
	City, State, ZIP Code :	Liberal, KS 67901		Application Number:	

3	MARK WELL'S LOCATION WITH AN "X" IN SECTION BOX:	4	DEPTH OF WELL 340 ft.												
			WELL'S STATIC WATER LEVEL 120 ft.												
			WELL WAS USED AS:												
			<table style="width:100%;"> <tr> <td style="width:33%;"><input checked="" type="radio"/> 1 Domestic</td> <td style="width:33%;">5 Public Water Supply</td> <td style="width:33%;">9 Dewatering</td> </tr> <tr> <td><input type="radio"/> 2 Irrigation</td> <td>6 Oil Field Water Supply</td> <td>10 Monitoring Well</td> </tr> <tr> <td><input type="radio"/> 3 Feedlot</td> <td>7 Domestic (Lawn & Garden)</td> <td>11 Injection Well</td> </tr> <tr> <td><input type="radio"/> 4 Industrial</td> <td>8 Air Conditioning</td> <td>12 Other</td> </tr> </table>	<input checked="" type="radio"/> 1 Domestic	5 Public Water Supply	9 Dewatering	<input type="radio"/> 2 Irrigation	6 Oil Field Water Supply	10 Monitoring Well	<input type="radio"/> 3 Feedlot	7 Domestic (Lawn & Garden)	11 Injection Well	<input type="radio"/> 4 Industrial	8 Air Conditioning	12 Other
<input checked="" type="radio"/> 1 Domestic	5 Public Water Supply	9 Dewatering													
<input type="radio"/> 2 Irrigation	6 Oil Field Water Supply	10 Monitoring Well													
<input type="radio"/> 3 Feedlot	7 Domestic (Lawn & Garden)	11 Injection Well													
<input type="radio"/> 4 Industrial	8 Air Conditioning	12 Other													
			Was a chemical / bacteriological sample submitted to Department? Yes No <input checked="" type="checkbox"/>												
			If yes, mo/day/yr sample was submitted												
			Water Well Disinfected: Yes <input checked="" type="checkbox"/> No												

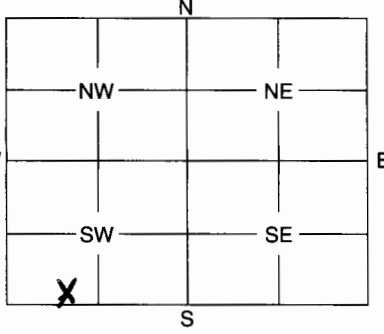

5	TYPE OF BLANK CASING USED:														
	<table style="width:100%;"> <tr> <td style="width:25%;"><input checked="" type="radio"/> 1 Steel</td> <td style="width:25%;">3 RMP (SR)</td> <td style="width:25%;">5 Wrought</td> <td style="width:25%;">7 Fiberglass</td> <td style="width:20%;">9 Other (Specify below)</td> </tr> <tr> <td><input checked="" type="radio"/> 2 PVC</td> <td>4 ABS</td> <td>6 Asbestos-Cement</td> <td>8 Concrete Tile</td> <td></td> </tr> </table>	<input checked="" type="radio"/> 1 Steel	3 RMP (SR)	5 Wrought	7 Fiberglass	9 Other (Specify below)	<input checked="" type="radio"/> 2 PVC	4 ABS	6 Asbestos-Cement	8 Concrete Tile					
<input checked="" type="radio"/> 1 Steel	3 RMP (SR)	5 Wrought	7 Fiberglass	9 Other (Specify below)											
<input checked="" type="radio"/> 2 PVC	4 ABS	6 Asbestos-Cement	8 Concrete Tile												
	Blank casing diameter 6 in.	Was casing pulled?	Yes	No <input checked="" type="checkbox"/>	If yes, how much										
	Casing height above or below land surface 4.8 in.														

6	GROUT PLUG MATERIAL:	1 Neat cement 2 Cement grout 3 Bentonite 4 Other																							
	Grout Plug Intervals:	From ft. to ft., From ft. to ft., From to ft.																							
	What is the nearest source of possible contamination:																								
	<table style="width:100%;"> <tr> <td style="width:33%;">1 Septic tank</td> <td style="width:33%;">6 Seepage pit</td> <td style="width:33%;">11 Fuel storage</td> <td style="width:17%;">16 Other (specify below)</td> </tr> <tr> <td>2 Sewer lines</td> <td>7 Pit privy</td> <td>12 Fertilizer storage</td> <td></td> </tr> <tr> <td>3 Watertight sewer lines</td> <td>8 Sewage lagoon</td> <td>13 Insecticide storage</td> <td></td> </tr> <tr> <td>4 Lateral lines</td> <td>9 Feedyard</td> <td>14 Abandoned water well</td> <td></td> </tr> <tr> <td>5 Cess pool</td> <td>10 Livestock pens</td> <td>15 Oil well/Gas well</td> <td></td> </tr> </table>	1 Septic tank	6 Seepage pit	11 Fuel storage	16 Other (specify below)	2 Sewer lines	7 Pit privy	12 Fertilizer storage		3 Watertight sewer lines	8 Sewage lagoon	13 Insecticide storage		4 Lateral lines	9 Feedyard	14 Abandoned water well		5 Cess pool	10 Livestock pens	15 Oil well/Gas well					
1 Septic tank	6 Seepage pit	11 Fuel storage	16 Other (specify below)																						
2 Sewer lines	7 Pit privy	12 Fertilizer storage																							
3 Watertight sewer lines	8 Sewage lagoon	13 Insecticide storage																							
4 Lateral lines	9 Feedyard	14 Abandoned water well																							
5 Cess pool	10 Livestock pens	15 Oil well/Gas well																							
	Direction from well?	How many feet?																							

FROM	TO	PLUGGING MATERIALS
340	4	Cement Grout
4	Surface	Backfill

7	CONTRACTOR'S OF LANDOWNER'S CERTIFICATION: This water well was plugged under my jurisdiction and was completed on (mo/day/year) 11-03-07 and this record is true to the best of my knowledge and belief. Kansas Water Well Contractor's License No. <u>KWCL 430</u> This Water Well Record was completed on (mo/day/year) 11-03-07 under the business name of <u>Howard Drilling Co. Box 806 Beaver, OK 73952</u> by (signature) <i>Howard Drilling Co.</i>
----------	---

INSTRUCTIONS: Use typewriter or ball point pen. Please press firmly and print clearly. Please fill in blanks, underline or circle the correct answers. Send top three copies to Kansas Department of Health and Environment, Bureau of Water, Geology Section, 1000 SW Jackson St., Ste. 420, Topeka, Kansas 66612-1367. Telephone: 785/296-5522. Send one to Water Well Owner and retain one for your records.