

WATER WELL PLUGGING RECORD

Form WWC-5P

KSA 82a-1212

ID NO.


0042802

**1 LOCATION OF WATER WELL:** Fraction SW 1/4 SE 1/4 SE 1/4 Section Number 3 Township Number 35S Range Number 34 W  
 County: Seward

Distance and direction from nearest town or city street address of well if located within city?  
4' S, 20' W of Farthest South Grain Bin, West 2<sup>nd</sup> St. - Liberal

**2 WATER WELL OWNER:** Farm Credit Bank of Wichita  
 RR#, St. Address, Box #: W. 2<sup>nd</sup> Street  
 City, State, ZIP Code: Liberal, KS 67905

**Global Positioning System** (decimal degrees, min. of 4 digits)  
 Latitude: \_\_\_\_\_  
 Longitude: \_\_\_\_\_  
 Elevation: \_\_\_\_\_  
 Datum: \_\_\_\_\_  
 Data Collection Method: \_\_\_\_\_

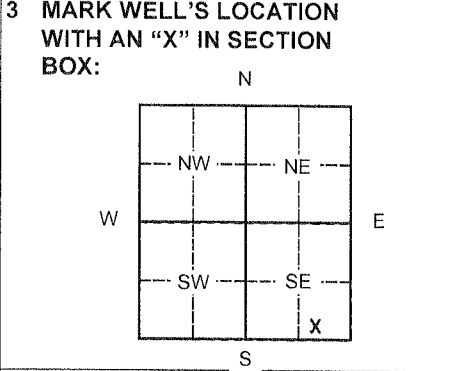

**4 DEPTH OF WELL** 148.50 ft.  
 WELL'S STATIC WATER LEVEL Not Measured ft.  
 WELL WAS USED AS:  
 1 Domestic      5 Public Water Supply      9 Dewatering  
 2 Irrigation      6 Oil Field Water Supply      10 Monitoring  
 3 Feedlot      7 Domestic (Lawn & Garden)      11 Injection Well  
 4 Industrial      8 Air Conditioning      12 Other \_\_\_\_\_

Was a chemical/bacteriological sample submitted to Department? Yes \_\_\_ No X

**5 TYPE OF BLANK CASING USED:**  
 1 Steel      3 RMP (SR)      5 Wrought      7 Fiberglass      9 Other (Specify below) \_\_\_\_\_  
 2 PVC      4 ABS      6 Asbestos-Cement      8 Concrete Tile \_\_\_\_\_

Blank casing diameter 4 in. Was casing pulled? Yes X No \_\_\_ If yes, how much 3 ft.  
 Casing height above or below land surface 36 in.

**6 GROUT PLUG MATERIAL:** 1 Neat cement      2 Cement grout      3 Bentonite      4 Other \_\_\_\_\_

Grout Plug Intervals: From 3 ft. to 148.5 ft., From \_\_\_\_\_ ft. to \_\_\_\_\_ ft., From \_\_\_\_\_ to \_\_\_\_\_ ft.

- What is the nearest source of possible contamination:
- |                          |                   |                         |                                |
|--------------------------|-------------------|-------------------------|--------------------------------|
| 1 Septic tank            | 6 Seepage pit     | 11 Fuel Storage         | 16 Other (specify below) _____ |
| 2 Sewer lines            | 7 Pit privy       | 12 Fertilizer storage   |                                |
| 3 Watertight sewer lines | 8 Sewage lagoon   | 13 Insecticide storage  |                                |
| 4 Lateral lines          | 9 Feedyard        | 14 Abandoned water well | Direction from well?           |
| 5 Cess pool              | 10 Livestock pens | 15 Oil well/Gas well    | How many feet?                 |

FROM	TO	PLUGGING MATERIALS	FROM	TO	PLUGGING MATERIALS
0	3	Native Soil			
3	148.5	Cement			

**7 CONTRACTOR'S OR LANDOWNER'S CERTIFICATION:** This water well was plugged under my jurisdiction and was completed on (mo/day/year) 09/29/10 and this record is true to the best of my knowledge and belief. Kansas Water Well Contractor's License No. 531. This Water Well Record was completed on (mo/day/year) 10/14/10 under the business name of Geotechnical Services, Inc. by (signature) Argi Ayada

**INSTRUCTIONS:** Please fill in blanks or circle the correct answers. Send top three copies to Kansas Department of Health and Environment, Bureau of Water, Geology Section, 1000 SW Jackson St., Ste. 420, Topeka, Kansas 66612-1367. Telephone: 785/296-5522. Send one to Water Well Owner and retain one for your records. Visit us at <http://www.kdheks.gov/waterwell>.