


1 LOCATION OF WATER WELL: Fraction E2 1/4 SE 1/4 NW 1/4 Section Number 6 Township Number T 35 S Range Number R 34W EW

Distance and direction from nearest town or city street address of well if located within city?
 6 MILES WEST OF LIBERAL, KS

2 WATER WELL OWNER: REDLAND RESOURCES #6-6 DOWDY
 RR#, St. Address, Box #: 6001 NW 23 Board of Agriculture, Division of Water Resources
 City, State, ZIP Code: OKLAHOMA CITY, OK 73127 Application Number: 940470

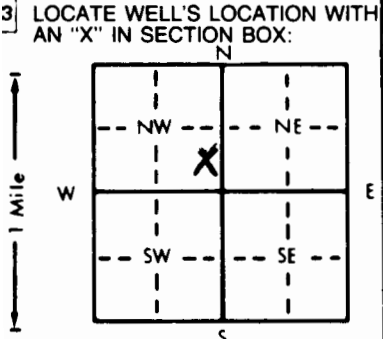

4 DEPTH OF COMPLETED WELL: 360 ft. ELEVATION: ...
 Depth(s) Groundwater Encountered 1. 132 ft. 2. ... ft. 3. ... ft.
 WELL'S STATIC WATER LEVEL 132 ft. below land surface measured on mo/day/yr 11-26-94
 Pump test data: Well water was 142 ft. after 1 hours pumping 75 gpm
 Est. Yield 75 gpm: Well water was ... ft. after ... hours pumping ... gpm
 Bore Hole Diameter 9 1/2 in. to 360 ft., and ... in. to ... ft.
 WELL WATER TO BE USED AS:
 1 Domestic 3 Feedlot 6 Oil field water supply 9 Dewatering 12 Other (Specify below)
 2 Irrigation 4 Industrial 7 Lawn and garden only 10 Monitoring well
 Was a chemical/bacteriological sample submitted to Department? Yes ... No X ... If yes, mo/day/yr sample was submitted
 Water Well Disinfected? Yes X No

5 TYPE OF BLANK CASING USED:
 1 Steel 3 RMP (SR) 5 Wrought iron 8 Concrete tile CASING JOINTS: Glued X Clamped
 2 PVC 4 ABS 6 Asbestos-Cement 9 Other (specify below) Welded
 7 Fiberglass Threaded
 Blank casing diameter 5 in. to 360 ft., Dia. ... in. to ... ft., Dia. ... in. to ... ft.
 Casing height above land surface 24 in., weight 2.902 lbs./ft. Wall thickness or gauge No. 265 SDR 21
 TYPE OF SCREEN OR PERFORATION MATERIAL:
 1 Steel 3 Stainless steel 5 Fiberglass 8 RMP (SR) 10 Asbestos-cement
 2 Brass 4 Galvanized steel 6 Concrete tile 9 ABS 12 None used (open hole)
 SCREEN OR PERFORATION OPENINGS ARE:
 1 Continuous slot 3 Mill slot 5 Gauzed wrapped 8 Saw cut 11 None (open hole)
 2 Louvered shutter 4 Key punched 6 Wire wrapped 9 Drilled holes
 7 Torch cut 10 Other (specify)
 SCREEN-PERFORATED INTERVALS: From 300 ft. to 360 ft., From ... ft. to ... ft.
 GRAVEL PACK INTERVALS: From 280 ft. to 360 ft., From ... ft. to ... ft.

6 GROUT MATERIAL: 1 Neat cement 2 Cement grout 3 Bentonite 4 Other HOLE PLUG
 Grout Intervals: From 1 ft. to 20 ft., From ... ft. to ... ft., From ... ft. to ... ft.
 What is the nearest source of possible contamination:
 1 Septic tank 4 Lateral lines 7 Pit privy 10 Livestock pens 14 Abandoned water well
 2 Sewer lines 5 Cess pool 8 Sewage lagoon 11 Fuel storage 15 Oil well/Gas well
 3 Watertight sewer lines 6 Seepage pit 9 Feedyard 12 Fertilizer storage 16 Other (specify below)
 13 Insecticide storage
 Direction from well? West How many feet? 120

FROM	TO	LITHOLOGIC LOG	FROM	TO	PLUGGING INTERVALS
0	2	SANDY CLAY	255	294	SANDY CLAY
2	5	SANDY CLAY	294	348	SAND
5	33	CLAY	348	360	BLUE CLAY
33	69	SANDY CLAY			
69	86	CLAY & SANDY CLAY			
86	107	CLAY			
107	114	SAND			
114	120	CALICHE SAND			
120	133	SAND			
133	167	CLAY			
167	194	SAND & SANDY CLAY			
194	215	SANDY CLAY			
215	231	SAND			
231	245	SANDY CLAY			
245	255	SAND			

7 CONTRACTOR'S OR LANDOWNER'S CERTIFICATION: This water well was (1) constructed, (2) reconstructed, or (3) plugged under my jurisdiction and was completed on (mo/day/year) 11-26-94 and this record is true to the best of my knowledge and belief. Kansas Water Well Contractor's License No. KWWCL-430 This Water Well Record was completed on (mo/day/year) 11-26-94 under the business name of HOWARD DRUG CO. BOX 806 BEAVER, OK 73932 by (signature)

INSTRUCTIONS: Use typewriter or ball point pen. PLEASE PRESS FIRMLY and PRINT clearly. Please fill in blanks, underline or circle the correct answers. Send top three copies to Kansas Department of Health and Environment, Bureau of Water, Topeka, Kansas 66620-0001. Telephone: 913-296-5545. Send one to WATER WELL OWNER and retain one for your records.