

1 LOCATION OF WATER WELL:	Fraction	Section Number	Township Number	Range Number
County: STEVENS	$\frac{1}{4}$ C $\frac{1}{4}$ SE $\frac{1}{4}$	9	T 35 S	R 35W E/W

Distance and direction from nearest town or city street address of well if located within city?

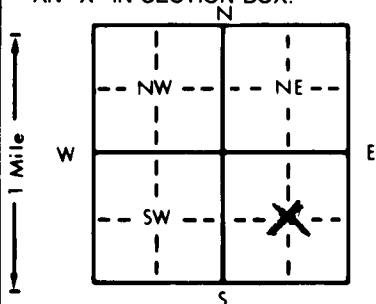
93/4 MILES SOUTH/SOUTHWEST WOODS, KS2 WATER WELL OWNER: **TEXACO EXPL. & PROD.**RR#, St. Address, Box #: **BOX 2700**City, State, ZIP Code: **PAMPA, TX 79066-2700**

"90-3 FIELDS M A"

Board of Agriculture, Division of Water Resources

Application Number: **950308**

3 LOCATE WELL'S LOCATION WITH AN "X" IN SECTION BOX:

4 DEPTH OF COMPLETED WELL: **320** ft. ELEVATION:Depth(s) Groundwater Encountered 1. **120** ft. 2. ft. 3. ft.WELL'S STATIC WATER LEVEL **120** ft. below land surface measured on mo/day/yr **09-27-95**Pump test data: Well water was **135** ft. after **1** hours pumping **100** gpmEst. Yield **100** gpm: Well water was ft. after hours pumping gpmBore Hole Diameter **11** in. to **320** ft., and in. to ft.

WELL WATER TO BE USED AS: 5 Public water supply 8 Air conditioning 11 Injection well

1 Domestic 3 Feedlot **6** Oil field water supply 9 Dewatering 12 Other (Specify below)

2 Irrigation 4 Industrial 7 Lawn and garden only 10 Monitoring well

Was a chemical/bacteriological sample submitted to Department? Yes.....No...**X**.....; If yes, mo/day/yr sample was submittedWater Well Disinfected? Yes **X** No

5 TYPE OF BLANK CASING USED:

1 Steel

3 RMP (SR)

5 Wrought iron

8 Concrete tile

CASING JOINTS: Glued **X** Clamped**2** PVC

4 ABS

6 Asbestos-Cement

9 Other (specify below)

Welded

Blank casing diameter **11** in. to **320**

7 Fiberglass

Threaded

Casing height above land surface **24** in., weight **2.902** lbs./ft. Wall thickness or gauge No. **.280 SDR 21**

TYPE OF SCREEN OR PERFORATION MATERIAL:

1 Steel

3 Stainless steel

5 Fiberglass

7 PVC

10 Asbestos-cement

2 Brass

4 Galvanized steel

6 Concrete tile

8 RMP (SR)

11 Other (specify)

12 None used (open hole)

SCREEN OR PERFORATION OPENINGS ARE:

1 Continuous slot

3 Mill slot

5 Gauzed wrapped

8 Saw cut

11 None (open hole)

2 Louvered shutter

4 Key punched

6 Wire wrapped

9 Drilled holes

SCREEN-PERFORATED INTERVALS: From **220** ft. to **320** ft., From ft. to ft.

From ft. to ft., From ft. to ft.

GRAVEL PACK INTERVALS: From **180** ft. to **320** ft., From ft. to ft.

From ft. to ft., From ft. to ft.

6 GROUT MATERIAL:

1 Neat cement

2 Cement grout

3 Bentonite

4 Other **HOLE PLUG**Grout Intervals: From **0** ft. to **16** ft., From ft. to ft., From ft. to ft.

What is the nearest source of possible contamination:

1 Septic tank

4 Lateral lines

7 Pit privy

10 Livestock pens

14 Abandoned water well

2 Sewer lines

5 Cess pool

8 Sewage lagoon

11 Fuel storage

15 Oil well/Gas well

3 Watertight sewer lines 6 Seepage pit

9 Feedyard

12 Fertilizer storage

16 Other (specify below)

13 Insecticide storage

Direction from well?

Southeast

How many feet?

200

FROM	TO	LITHOLOGIC LOG	FROM	TO	PLUGGING INTERVALS
0	10	SANDY CLAY			
10	34	SANDY CLAY & CLAY			
34	41	SAND			
41	74	SANDY CLAY & CLAY			
74	81	CLAY			
81	185	SANDY CLAY & CLAY			
185	189	CALICHE			
189	208	SANDY CLAY			
208	260	SAND & GRAVEL			
260	270	SAND & CLAY STREAKS			
270	292	SAND & GRAVEL			
292	298	SAND & CLAY STREAKS			
298	316	SAND & GRAVEL			
316	320	SANDY CLAY & CLAY			

7 CONTRACTOR'S OR LANDOWNER'S CERTIFICATION: This water well was **(1)** constructed, **(2)** reconstructed, or **(3)** plugged under my jurisdiction and was completed on (mo/day/year) **09-27-95** and this record is true to the best of my knowledge and belief. KansasWater Well Contractor's License No. **KWCL430** This Water Well Record was completed on (mo/day/yr) **09-27-95**under the business name of **HOWARD DRUG CO. BOX 806 BEAVER, OK 73932** by (signature) *[Signature]*