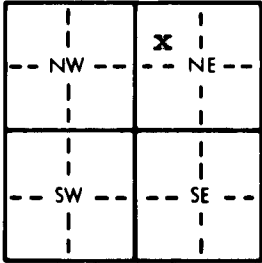
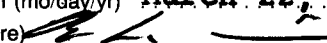


1 LOCATION OF WATER WELL:		Fraction	Section Number	Township Number	Range Number
County: Stevens		X C-NW 1/4 NE 1/4	14	T 35 S	R 35 EW
Distance and direction from nearest town or city street address of well if located within city? From Liberal go West on 2nd Street Road 8mi West 2mi South 1/2mi East Southeast to location.					
2 WATER WELL OWNER: Merian Vanderford Mid-Western Exploration Sage #6					
RR#, St. Address, Box # : 444 Cheryl Board of Agriculture, Division of Water Resources					
City, State, ZIP Code : Wichita, Kansas Application Number: T 84-141					
3 LOCATE WELL'S LOCATION WITH AN "X" IN SECTION BOX:		4 DEPTH OF COMPLETED WELL: 300 ft. ELEVATION:			
		Depth(s) Groundwater Encountered 1. 184 ft. 2. ft. 3. ft.			
		WELL'S STATIC WATER LEVEL 116 ft. below land surface measured on mo/day/yr 3/12/84			
		Pump test data: Well water was ft. after hours pumping gpm			
		Est. Yield 60 gpm: Well water was ft. after hours pumping gpm			
		Bore Hole Diameter 9 in. to 300 ft., and in. to ft.			
WELL WATER TO BE USED AS:					
1 Domestic 3 Feedlot <u>6 Oil field water supply</u> 9 Dewatering 11 Injection well					
2 Irrigation 4 Industrial 7 Lawn and garden only 10 Observation well					
Was a chemical/bacteriological sample submitted to Department? Yes.....No.....; If yes, mo/day/yr sample was submitted					
Water Well Disinfected? Yes No					
5 TYPE OF BLANK CASING USED:					
1 Steel 3 RMP (SR) 5 Wrought iron 8 Concrete tile CASING JOINTS: <u>Glued</u> Clamped					
2 <u>PVC</u> 4 ABS 6 Asbestos-Cement 9 Other (specify below) Welded					
7 Fiberglass Threaded					
Blank casing diameter 5 in. to 220 ft., Dia. in. to ft., Dia. in. to ft.					
Casing height above land surface 28 in., weight 2.85 lbs./ft. Wall thickness or gauge No. 265					
TYPE OF SCREEN OR PERFORATION MATERIAL:					
1 Steel 3 Stainless steel 5 Fiberglass 8 RMP (SR) 10 Asbestos-cement					
2 Brass 4 Galvanized steel 6 Concrete tile 9 ABS 11 Other (specify)					
12 None used (open hole)					
SCREEN OR PERFORATION OPENINGS ARE:					
1 Continuous slot 5 Gauzed wrapped 8 Saw cut 11 None (open hole)					
2 Louvered shutter 3 Mill slot 6 Wire wrapped 9 Drilled holes					
4 Key punched 7 Torch cut 10 Other (specify)					
SCREEN-PERFORATED INTERVALS: From 220 ft. to 300 ft., From ft. to ft.					
GRAVEL PACK INTERVALS: From 120 ft. to 300 ft., From ft. to ft.					
6 GROUT MATERIAL:					
1 Neat cement 2 Cement grout 3 Bentonite 4 Other					
Grout Intervals: From 0 ft. to 10 ft., From ft. to ft.					
What is the nearest source of possible contamination:					
1 Septic tank 4 Lateral lines 7 Pit privy 10 Livestock pens 14 Abandoned water well					
2 Sewer lines 5 Cess pool 8 Sewage lagoon 11 Fuel storage 15 Oil well/Gas well					
3 Watertight sewer lines 6 Seepage pit 9 Feedyard 12 Fertilizer storage 16 Other (specify below)					
13 Insecticide storage					
Direction from well? Northeast of water well. How many feet? 100'					
FROM		TO		LITHOLOGIC LOG	
0		2		surface	
2		21		sandy clay	
21		106		clay	
106		135		sandy clay	
135		173		clay	
173		182		whiterock	
182		218		clay	
218		265		sandy clay	
265		283		medium to large sand	
283		300		sandy clay with fine sand	
7 CONTRACTOR'S OR LANDOWNER'S CERTIFICATION: This water well was (1) constructed, (2) reconstructed, or (3) plugged under my jurisdiction and was completed on (mo/day/year) March 12, 1984 and this record is true to the best of my knowledge and belief. Kansas					
Water Well Contractor's License No. 118 This Water Well Record was completed on (mo/day/yr) March 22, 1984					
under the business name of Carlile Water Well Service, Inc. by (signature) 					
INSTRUCTIONS: Use typewriter or ball point pen, PLEASE PRESS FIRMLY and PRINT clearly. Please fill in blanks, underline or circle the correct answers. Send top three copies to Kansas Department of Health and Environment, Division of Environment, Environmental Geology Section, Topeka, KS 66620. Send one to WATER WELL OWNER and retain one for your records.					