

1) LOCATION OF WATER WELL:		Fraction	Section Number	Township Number	Range Number
County: STEVENS	C $\frac{1}{4}$ NE $\frac{1}{4}$ NW $\frac{1}{4}$	11	T 35 S	R 36W E/W	


Distance and direction from nearest town or city street address of well if located within city?

10 MILES SOUTHWEST WOODS, KS

2 WATER WELL OWNER: ~~XXXXXXXXXXXX~~ *Bereved, Inc.*
 RR#, St. Address, Box #: *401 E. DOWNS, # 402 970 4th Fin Ctr.*
 City, State, ZIP Code: *Wichita, KS 67202*

#1-11 CASE#
 Board of Agriculture, Division of Water Resources
 Application Number: **940488**

3 LOCATE WELL'S LOCATION WITH AN "X" IN SECTION BOX: 4 DEPTH OF COMPLETED WELL: 360 ft. ELEVATION:

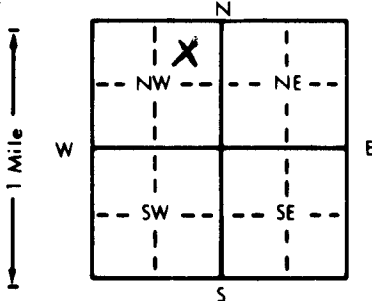

4 DEPTH OF COMPLETED WELL 360 ft. ELEVATION: _____

Depth(s) Groundwater Encountered 1. _____ ft. 2. _____ ft. 3. _____ ft.

WELL'S STATIC WATER LEVEL 140 ft. below land surface measured on mo/day/yr 04-24-96

Pump test data: Well water was _____ ft. after _____ hours pumping _____ gpm

Est. Yield _____ gpm: Well water was _____ ft. after _____ hours pumping _____ gpm

Bore Hole Diameter _____ in. to _____ ft., and _____ in. to _____ ft.

WELL WATER ~~DOES~~ USED AS:

1 Domestic WAS	3 Feedlot	5 Public water supply	8 Air conditioning	11 Injection well
2 Irrigation	4 Industrial	6 <u>X</u> Oil field water supply	9 Dewatering	12 Other (Specify below)
		7 Lawn and garden only	10 Monitoring well	

Was a chemical/bacteriological sample submitted to Department? Yes _____ No _____; If yes, mo/day/yr sample was submitted _____

Water Well Disinfected? Yes _____ No _____

5 TYPE OF BLANK CASING USED:

1 Steel	3 RMP (SR)	5 Wrought iron	8 Concrete tile	CASING JOINTS: Glued	Clamped
2 PVC	4 ABS	6 Asbestos-Cement	9 Other (specify below)	Welded	
		7 Fiberglass		Threaded	

Blank casing diameter 6 in. to 360 ft., Dia. in. to ft., Dia. in. to ft.

Casing height above land surface 5' BELOW in., weight lbs./ft. Wall thickness or gauge No.

TYPE OF SCREEN OR PERFORATION MATERIAL:

1 Steel	3 Stainless steel	5 Fiberglass	7 PVC	10 Asbestos-cement
2 Brass	4 Galvanized steel	6 Concrete tile	8 RMP (SR)	11 Other (specify)
			9 ABS	12 None used (open hole)

SCREEN OR PERFORATION OPENINGS ARE:


1 Continuous slot	3 Mill slot	5 Gauzed wrapped	8 Saw cut	11 None (open hole)
2 Louvered shutter	4 Key punched	6 Wire wrapped	9 Drilled holes	
		7 Torch cut	10 Other (specify)	

SCREEN-PERFORATED INTERVALS: From ft. to ft., From ft. to ft., From ft. to ft.

GRAVEL PACK INTERVALS: From ft. to ft., From ft. to ft., From ft. to ft.

6 GROUT MATERIAL: 1 Neat cement 2 Cement grout 3 Bentonite 4 Other
Grout Intervals: From 8 ft. to 5 ft., From ft. to ft., From ft. to ft.
What is the nearest source of possible contamination:
1 Septic tank 4 Lateral lines 7 Pit privy 10 Livestock pens 14 Abandoned water well
2 Sewer lines 5 Cess pool 8 Sewage lagoon 11 Fuel storage 15 Oil well/Gas well
3 Watertight sewer lines 6 Seepage pit 9 Feedyard 12 Fertilizer storage 16 Other (specify below)
13 Insecticide storage

[illegible]

7 CONTRACTOR'S OR LANDOWNER'S CERTIFICATION: This water well was (1) constructed, (2) reconstructed, or (3) plugged under my jurisdiction and was completed on (mo/day/year) 04-24-96 and this record is true to the best of my knowledge and belief. Kansas Water Well Contractor's License No. KWCL-430. This Water Well Record was completed on (mo/day/yr) 04-24-96 under the business name of HOWARD DRUG CO. BOX 806 BEAVER, OK 73932 by (signature) 

INSTRUCTIONS: Use typewriter or ball point pen. PLEASE PRESS FIRMLY and PRINT clearly. Please fill in blanks, underline or circle the correct answers. Send top three copies to Kansas Department of Health and Environment, Bureau of Water, Topeka, Kansas 66620-0001. Telephone: 913-296-5545. Send one to WATER WELL OWNER and retain one for your records.

#22930