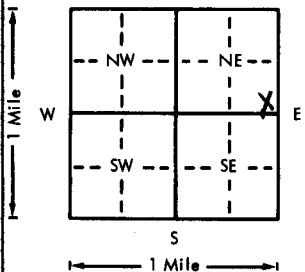


USE TYPEWRITER OR BALL
POINT PEN-PRESS FIRMLY,
PRINT CLEARLY.

WATER WELL RECORD
KSA 82a-1201-1215

Kansas Department of Health and
Environment-Division of Environment
(Water well Contractors)
Topeka, Kansas 66620

1. Location of well:		County Stevens	Fraction SE 1/4 SE 1/4 NE 1/4	Section number 13	Township number T 35 S R 36 E/W	Range number
2. Distance and direction from nearest town or city: 9 EAST OF HUGOTON, KAN Street address of well location if in city:				3. Owner of well: Harold Cox R.R. or street: 210 West 11th City, state, zip code: Hugoton, KAN 67951		
4. Locate with "X" in section below:		Sketch map:		6. Bore hole dia. 26 in. Completion date 5-8-76 Well depth 684 ft.		
				7. <input checked="" type="checkbox"/> Cable tool <input checked="" type="checkbox"/> Rotary <input type="checkbox"/> Driven <input type="checkbox"/> Dug <input type="checkbox"/> Hollow rod <input type="checkbox"/> Jetted <input type="checkbox"/> Bored <input type="checkbox"/> Reverse rotary		
5. Type and color of material				8. Use: <input type="checkbox"/> Domestic <input type="checkbox"/> Public supply <input type="checkbox"/> Industry <input checked="" type="checkbox"/> Irrigation <input type="checkbox"/> Air conditioning <input type="checkbox"/> Stock <input type="checkbox"/> Lawn <input type="checkbox"/> Oil field water <input type="checkbox"/> Other		
				9. Casing: Material Steel Height: Above or below Threaded <input type="checkbox"/> Welded <input checked="" type="checkbox"/> Surface 17 in. RMP <input type="checkbox"/> PVC <input type="checkbox"/> Weight 42.5 lbs./ft. Dia 16 in. to 684 ft. depth Wall Thickness: inches or Dia. <input type="checkbox"/> in. to <input type="checkbox"/> ft. depth gage No. 1250		
Overburden				10. Screen: Manufacturer's name L.B. Foster		
Top Soil				Type Steel Dia. 16 Slot/gauze 1/8 Length 3' 3/8 Set between 276 ft. and 664 ft. ft. and <input type="checkbox"/> ft. Gravel pack? <input checked="" type="checkbox"/> Size range of material 1/8-1/4		
Fine & Med. Sd. w/Coarse Sd.				11. Static water level: 105 ft. below land surface Date 5/11/76 mo./day/yr.		
Fine & Med. Sd. w/Sd.stone & Rock				12. Pumping level below land surfaces: NA ft. after <input type="checkbox"/> hrs. pumping <input type="checkbox"/> g.p.m. ft. after <input type="checkbox"/> hrs. pumping <input type="checkbox"/> g.p.m. Estimated maximum yield <input type="checkbox"/> g.p.m.		
Fine Sd. & Sd.stone				13. Water sample submitted: <input type="checkbox"/> Yes <input checked="" type="checkbox"/> No Date <input type="checkbox"/> mo./day/yr.		
Fine & Med. Sd.				14. Well head completion: NA <input type="checkbox"/> Pitless adapter <input type="checkbox"/> Inches above grade		
Fine Sd. w/Clay				15. Well grouted? Yes With: <input checked="" type="checkbox"/> Neat cement <input type="checkbox"/> Bentonite <input type="checkbox"/> Concrete Depth: From 0 ft. to 10 ft.		
Fine & Med. Sd.				16. Nearest source of possible contamination: ft. <input type="checkbox"/> Direction <input type="checkbox"/> Type <input type="checkbox"/> Well disinfected upon completion? <input type="checkbox"/> Yes <input checked="" type="checkbox"/> No		
Med. & Coarse Sd.				17. Pump: <input checked="" type="checkbox"/> Not installed Manufacturer's name <input type="checkbox"/> HP <input type="checkbox"/> Volts <input type="checkbox"/> Length of drop pipe <input type="checkbox"/> ft. capacity <input type="checkbox"/> g.p.m. Type: <input type="checkbox"/> Submersible <input type="checkbox"/> Turbine <input type="checkbox"/> Jet <input type="checkbox"/> Reciprocating <input type="checkbox"/> Centrifugal <input type="checkbox"/> Other		
Red Bed				20. Water well contractor's certification: This well was drilled under my jurisdiction and this report is true to the best of my knowledge and belief. K1A Drilling, Inc 225 Business name License No. Address P.O. Box 1395, Hugoton, Okla Signed Rocky Weiler Date 6/4/76 Authorized representative		
18. Elevation:				19. Remarks: 10A Johnson Trce Steel 16" 1000 SLOP 664-684' 16A Coop Land		
Topography: <input type="checkbox"/> Hill <input type="checkbox"/> Slope <input checked="" type="checkbox"/> Upland <input type="checkbox"/> Valley						

35
36
13
SESE NE
1/4 1/4 3/4