USE TYPEWRITER OR BALL POINT PEN-PRESS FIRMLY, PRINT CLEARLY.

T R EW sec 1/4 1/4 1/4 No.

WATER WELL RECORD
KSA 82a-1201-1215

Kansas State Dept. Of Health
(Water Well Contractors)
Forbes-Bldg. 740
Topeka, Kansas 66620

1 Location of well:	County	Township name	Fraction	Section number	Town number	Range number
	Stevens		NE, NE, NE	15	T35S	R36W

Distance and direction from nearest town or city:

Street address of well location if in city:

3 Owner of well: Dwain Towner
Address: R. R. 2
Hugoton, Ks

Locate with "X" in section below:

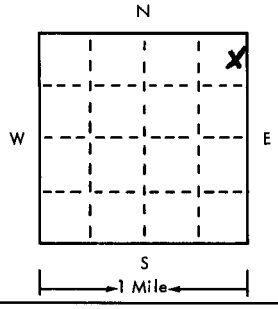

Sketch map:

4 Well depth: 581 ft. Date of completion _____
Well diameter 28 in. 31 Mar 75

5 ☐ Cable tool ☐ Rotary ☐ Driven ☐ Dug
☐ Hollow rod ☐ Jetted ☐ Bored ☒ Reverse rotary

6 Use: ☐ Domestic ☐ Public supply ☐ Industry
☒ Irrigation ☐ Air conditioning ☐ Commercial
☐ Test well ☐ _____

7 Casing: Material steel Height: above/~~below~~
Threaded ☐ Welded ☒ Surface 12 in.
Diam. Weight 37 lbs./ft. ___
16 in. to 581 ft. depth Drive shoe? ☐ Yes ☒ No
___ in. to ___ ft. depth

2

Type and color of material	From	To
Well drilled near the site of		
TH 2-74 (see attached), which		
is 660' S. of the NE cor. of		
Sec. 15, 35-36, Stevens Co.		
(use a second sheet if needed)		

8 Screen: W. A. Brown T
Manufacturer L. B. Foster
Type Louver T mid. slot 16"
Slot/gauze 118" Length 286'
Set between 295 ft. and 581 ft. ___
Fittings: .6 - 5 mm
Gravel pack ☒ Yes ☐ No Size range of material ___

9 Static water level:
121 ft. below land surface Date 28 Jan 75

10 Pumping level below land surfaces:
194 ft. after 1 hrs. pumping ~~1000~~ 992 g.p.m.
261 ft. after 1 hrs. pumping 753 g.p.m.
Estimated maximum yield 2000 g.p.m.

11 Water sample submitted:
☐ Yes ☒ No Date _____

12 Well head completion:
☐ Pitless adapter ☒ Inches above grade

13 Well grouted? ☒ Yes ☐ No
☐ Neat cement ☒ Bentonite ☐ _____
Depth: From 0 ft. to 10 ft.

14 Nearest source of possible contamination: Unk
ft. _____ Direction _____ Type _____
Well disinfected upon completion? ☒ Yes ☐ No

15 Pump: ☐ Not installed
Manufacturer's name Layne
Model number 12TL HP 200 Volts ___
Length of drop pipe 320 ft. capacity 1500 g.m.p.
Type:
☐ Submersible ☒ Turbine
☐ Jet ☐ Reciprocating
☐ Certrifugal ☐ Other

16 Remarks: elevation

Topography:
☐ Hill
☐ Slope
☒ Upland
☐ Valley

17 Water well contractor's certification:
This well was drilled under my jurisdiction and this report is true to the best of my knowledge and belief.
Layne-Western Co 150
Business name License No.
Address Garden City
Signed [signature] Date 14 May 75
Authorized representative

Forward the white, blue and pink copies to the Kansas State Dept. Of Health.

Form WWC-5

TEST HOLE REPORT

Layne-Western Company, Inc.

WATER SUPPLY SERVICES SINCE 1924

TEST DRILLING • WATER WELLS • PUMPS

P.O. Box 686 - W. Hwy. 50
Garden City, Kansas 67846

Contract Name Dwain Towner

Job No. K-467 Date 11-2-74

City Hugoton State Kansas

TEST HOLE
No. 2-74

Driller McIntyre

Location of Test Hole 660' South of the N.E. corner of

¼ NE ¼ Sec. 15 of T 35S,

R 36W, Stevens Co., Kansas.

Elevation of Test Hole

Static Water Level 121'

Measured in well Hours After Completion

From	To	Description of Strata	Water Bearing	
0	2	Top soil		
2	78	Tan clay and caliche		
78	110	Fine to coarse sand with fine to medium gravel		
110	220	Tan sandy clay		
220	302	Tan sandy clay with sand lenses		
302	312	Tan clay with hard limestone lenses		
312	261	Fine to coarse sand some clay lenses		
361	440	Tan green and brown sandy clay		
440	581	Fine to coarse sand loose		
581	600	Tan clay		

Remarks:

Well site - Jan., 75
1753 gpm @ 261 PWL (140' DD)