

KSA 82a-1212


1 LOCATION OF WATER WELL:	Fraction	Section Number	Township Number	Range Number
County: <i>Stevens</i>	<i>SW ¼ SW ¼ NW ¼</i>	<i>16</i>	T <i>35</i> S	R <i>37</i> E

Distance and direction from nearest town or city street address of well if located within city?
From County Roads 12 & B - 1/2 South on 12

2 WATER WELL OWNER: Richard Claggett
RR#, St. Address, Box # 1281 Rd. B
City, State, ZIP Code Norton, KS 67957

Board of Agriculture, Division of Water Resources
Application Number: _____

3 LOCATE WELL'S LOCATION WITH AN "X" IN SECTION BOX: 4 DEPTH OF COMPLETED WELL 420 ft. ELEVATION: _____

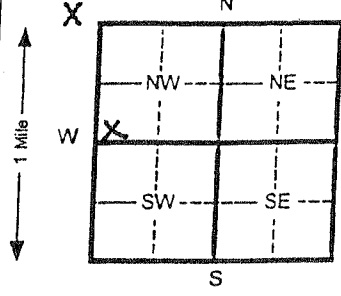

4 DEPTH OF COMPLETED WELL 420 ft. ELEVATION: _____
Depth(s) Groundwater Encountered 1 _____ ft. 2 _____ ft. 3 _____ ft.

WELL'S STATIC WATER LEVEL 260 ft. below land surface measured on mo/day/yr 5-25-12

Pump test data:	Well water was	_____	ft. after	_____	hours pumping	_____	gpm
Est. Yield	_____ gpm:	Well water was	_____	ft. after	_____	hours pumping	_____ gpm

WELL WATER TO BE USED AS: 5 Public water supply 8 Air conditioning 11 Injection well

1 Domestic	3 Feed lot	6 Oil field water supply	9 Dewatering	12 Other (Specify below)
2 Irrigation	4 Industrial	7 Lawn and garden (domestic)	10 Monitoring well	

Was a chemical/bacteriological sample submitted to Department? Yes _____ No _____ If yes, mo/day/yr sample was submitted _____

Water Well Disinfected? Yes _____ No _____

5 TYPE OF BLANK CASING USED: 5 Wrought Iron 8 Concrete tile CASING JOINTS: Glued _____ Clamped _____

1 Steel	3 RMP (SR)	6 Asbestos-Cement	9 Other (specify below)	Welded
2 PVC	4 ABS	7 Fiberglass		Threaded

Blank casing diameter _____ in. to _____ ft., Dia _____ in. to _____ ft., Dia _____ in. to _____ ft.

Casing height above land surface _____ in., weight _____ lbs./ft. Wall thickness or gauge No. _____
 TYPE OF SCREEN OR PERFORATION MATERIAL: _____ 7 PVC _____ 10 Asbestos-cement

1 Steel	3 Stainless steel	5 Fiberglass	8 RMP (SR)	11 Other (specify) _____
2 Brass	4 Galvanized steel	6 Concrete tile	9 ABS	12 None used (open hole)

SCREEN OR PERFORATION OPENINGS ARE:

1 Continuous slot	3 Mill slot	5 Gauzed wrapped	8 Saw cut	11 None (open hole)
		6 Wire wrapped	9 Drilled holes	

1 Continuous slot 3 Mini slot 5 Wire wrapped
2 Louvered shutter 4 Key punched 7 Torch cut 10 Other (specify) _____

SCREEN PERFORATED INTERVALS: ft. to ft. From ft. to ft.

SCREEN #	INTEGRATED INTERVALS:	From	ft. to	ft. From	ft. to	ft.
		From	ft. to	ft. From	ft. to	ft.
		From	ft. to	ft. From	ft. to	ft.

GRAVEL PACK INTERVALS.		From	ft. to	ft. From	ft. to	ft.
		From	ft. to	ft. From	ft. to	ft.
8. COBBLE MATERIAL	1. Noncement			3. Recement	4. Other	

GROUT MATERIAL:		1 Neat cement	2 Cement grout	3 Bentonite	4 Other
Grout Intervals	From _____ ft. to _____ ft.	From _____ ft. to _____ ft.	From _____ ft. to _____ ft.	From _____ ft. to _____ ft.	From _____ ft. to _____ ft.
				10. Livestock pens	14. Abandoned water well

1 Septic tank	4 Lateral lines	7 Pit privy	10 Livestock pens	13 Roadside
2 Sewer lines	5 Cess pool	8 Sewage lagoon	11 Fuel storage	14 Oil well/ Gas well
3 Sewage treatment plant	6 Other (specify below)	9 Other (specify below)	12 Fertilizer storage	15 Other (specify below)

2 Sewer lines	5 Cess pool	8 Sewage lagoon	12 Fertilizer storage
3 Watertight sewer lines	6 Seepage pit	9 Feedyard	13 Insecticide storage

How many feet?

FROM			TO			PLUGGING INTERVALS		

				420	220	Gravel Fill
				220	212	Bentonite Plug

				212	15	Compacted Fill:
				15	5	Cement Plug

[illegible][illegible]

[illegible]

CONTRACTOR'S OR LANDOWNER'S CERTIFICATION: This water well was: (1) constructed, (2) reconstructed, or (3) plugged under my jurisdiction and

and this record is true to the best of my knowledge and belief. Kansas

Water Well Contractor's License No. 473 This Water Well Record was completed on (mo/day/yr) 5-27-12
by (signature) Richard L. Hochman

INSTRUCTIONS: Please fill in blanks and circle the correct answers. Send three copies to Kansas Department of Health and Environment, Bureau of Water, Topeka, Kansas 66620-0001. Telephone: 913-296-5545. Send one to WATER WELL OWNER and retain one for your records.