

WATER WELL RECORD Form WWC-5


Division of Water Resources App. No.

Well ID

Original Record Correction Change in Well Use

1 LOCATION OF WATER WELL: County: Stevens Fraction: NE SE NW SW Section Number: 11 Township Number: T 35 S Range Number: R 27 E W

2 WELL OWNER: Last Name: Sullivan First: Abel Street or Rural Address where well is located: 10 miles South & 2 miles East of Hugoton

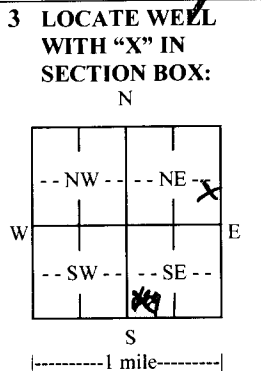

4 DEPTH OF COMPLETED WELL: 506 ft. Depth(s) Groundwater Encountered: 1) 202 ft. WELL'S STATIC WATER LEVEL: 202 ft.

5 Latitude: Longitude: Datum: WGS 84 NAD 83 NAD 27 Source for Latitude/Longitude: GPS (unit make/model):

7 WELL WATER TO BE USED AS: 1. Domestic: [X] Household [] Lawn & Garden [] Livestock [] Irrigation [] Feedlot [] Industrial

Was a chemical/bacteriological sample submitted to KDHE? [] Yes [X] No If yes, date sample was submitted:

8 TYPE OF CASING USED: [] Steel [X] PVC [] Other CASING JOINTS: [X] Glued [] Clamped [] Welded [] Threaded

9 GROUT MATERIAL: [] Neat cement [] Cement grout [X] Bentonite [] Other

Nearest source of possible contamination: [X] Septic Tank [] Lateral Lines [] Pit Privy [] Livestock Pens [] Insecticide Storage

Table with columns: FROM, TO, LITHOLOGIC LOG, FROM, TO, LITHO. LOG (cont.) or PLUGGING INTERVALS. Includes entries for Surface, Caliche & Gray Clay, Sandy Clay, etc.

11 CONTRACTOR'S OR LANDOWNER'S CERTIFICATION: This water well was [X] constructed, [] reconstructed, or [] plugged under my jurisdiction and was completed on (mo-day-year) 10-23-14