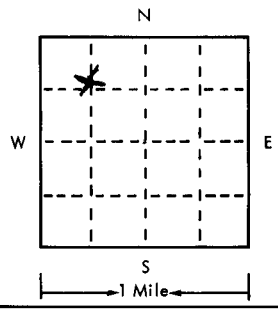


USE TYPEWRITER OR BALL
POINT PEN-PRESS FIRMLY,
PRINT CLEARLY.

WATER WELL RECORD
KSA 82a-1201-1215

T R EW sec 1/4 1/4 1/4 No.

Kansas State Dept. Of Health
(Water Well Contractors)
Forbes-Bldg. 740
Topeka, Kansas 66620

1 Location of well:		County Stevens Marion	Township name	Fraction NW 1/4	Section number 7	Town number 35	Range number 37
Distance and direction from nearest town or city: 9.5 - 2W - 14S OF HUGOTON				3 Owner of well: Gerald Elliott			
Street address of well location if in city:				Address: HUGOTON, KANSAS			
Locate with "X" in section below:		Sketch map:		4 Well depth: 627 ft. Date of completion 9/9/76 Well diameter 2 1/2 in.			
				5 ☐ Cable tool ☒ Rotary ☐ Driven ☐ Dug ☐ Hollow rod ☐ Jetted ☐ Bored ☐ Reverse rotary			
				6 Use: ☐ Domestic ☐ Public supply ☐ Industry ☒ Irrigation ☐ Air conditioning ☐ Commercial ☐ Test well			
				7 Casing: Material Steel Height: above/below Threaded ☐ Welded ☒ Surface 12 in. Dia. 16 in. to 627 ft. depth Drive shoe? ☐ Yes ☒ No 16 in. to 627 ft. depth			
2		Type and color of material		From	To	8 Screen:	
		Overburden		0	2	Manufacturer L.B. Foster	
		Top Soil		2	160	Type Steel Dia. 16	
		Coarse Sd., Clay & Rock		160	240	Slot/gauze 1/8 Length 311	
		Coarse Sd. & Gravel		240	580	Set between 226 ft. and 607 ft.	
		Gravel		580	630	Fittings: 1/8 - 1/4	
		Gravel & Red Clay		630	660	Gravel pack ☒ Yes ☐ No Size range of material	
						9 Static water level:	
						122 ft. below land surface Date 3/26/76	
						10 Pumping level below land surfaces: NA	
						____ ft. after ____ hrs. pumping ____ g.p.m.	
						____ ft. after ____ hrs. pumping ____ g.p.m.	
						Estimated maximum yield ____ g.p.m.	
						11 Water sample submitted:	
						☐ Yes ☒ No Date	
						12 Well head completion:	
						☐ Pitless adapter NA ☐ Inches above grade	
						13 Well grouted? ☒ Yes ☐ No	
						☒ Neat cement ☐ Bentonite	
						Depth: From 0 ft. to 10 ft.	
						14 Nearest source of possible contamination:	
						ft. ____ Direction ____ Type ____	
						Well disinfected upon completion? ☐ Yes ☒ No	
						15 Pump:	
						☐ Not installed	
						Manufacturer's name	
						Model number ____ HP ____ Volts ____	
						Length of drop pipe ____ ft. Capacity ____ g.p.m.	
						Type Pump Set by Thied Path	
						☐ Submersible ☐ Turbine	
						☐ Jet ☐ Reciprocating	
						☐ Centrifugal ☐ Other	
16 Remarks: elevation				17 Water well contractor's certification:			
				This well was drilled under my jurisdiction and this report is true to the best of my knowledge and belief.			
				KTM DRILLING, INC. 225			
				Business name			
				Address Box 1385, Guyman, Okla. License No.			
				Signed Rockney Archer Date 3-26-76			
				Authorized representative			

35 37W 7 NW